

Stafford


KANSAS

FORM 51 5M 2-38 TPCO.

Section 12 Township 22 Range 13-W

Well No. 1 Carl Drach

Company Stanolind

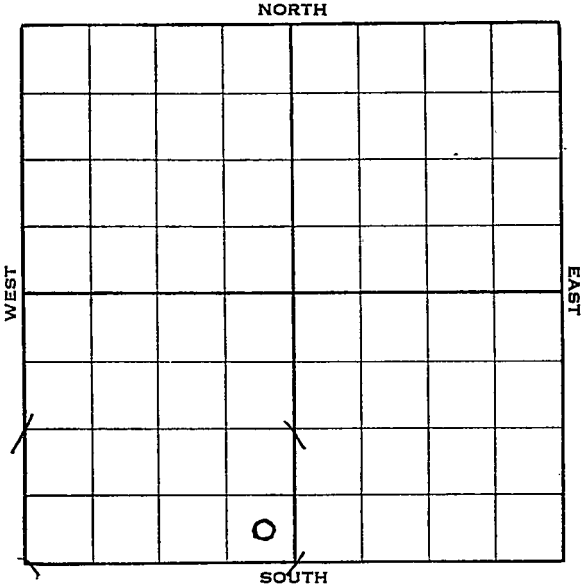

Sec. 12 Twp. 22 R. 13-W

Well No. #1 Carl Drach Farm
Stanolind Company


_____ Ft. from N. Line

330 Ft. from S. Line

330 Ft. from E. Line

_____ Ft. from W. Line

Elev. 1884

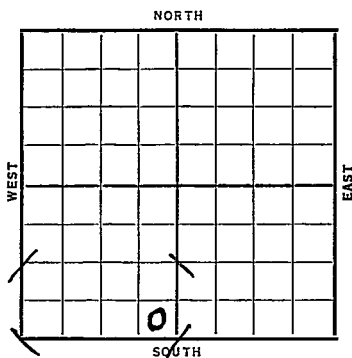

Date	REPORT
1938	
3/9	R U R
3/18	10" @ 260'. Anhy 735'. Drlg. 2145'.
3/25	Drlg. 3568'.
4/1	Lans. 3355'. Viola 3620'. Simp. sh. 3665'. Arb. 3728-37'.
4/8	T.D. 3737'. Spotted sat. 6" @ 3730'. RUST.
4/13	TD 3772'. 1 BWPB S. D. O.
4/13	6" @ 3730'. Arb. 3728'. T.D. 3772'.
	ABANDONED

Map No. 82 Sec. 12 Twp. 22 R. 13WWell No. 1 Carl DrachStanolind

Company

Contractor

FIRST REPORT

SE SW

_____ Ft. from N. Line

330 Ft. from S. Line330 Ft. from E. Line

_____ Ft. from W. Line

SECTION PLAT

Location _____

Rig up _____

Drilling and Remarks:

RUR**RECORD**

Cased _____ in., _____ ft.

Sand _____

Gas _____

Oil _____

Total Depth _____

PRODUCTION

1st 24 hrs. Nat. _____

1st 24 hrs. after shot _____

Gas _____ Cu. Ft.

Dry Hole _____

Abandoned _____

Date

MAR 9 - 1938 19

H. D. Hatfield Scout

Stafford KANSAS

Map No. 82 Sec. 12 Twp. 22 R. 13WWell No. 1 Carl DrachStanolind

Company

Contractor

ABANDONED

SE SW

_____ Ft. from N. Line

330 Ft. from S. Line330 Ft. from E. Line

_____ Ft. from W. Line

SECTION PLAT

Location _____

Rig up _____

Drilling and Remarks:

DVA

RECORD

Cased 6 in., 3730 ft.Sand Arb 3728

Gas _____

Oil _____

Total Depth 3772

PRODUCTION

1st 24 hrs. Nat. _____

1st 24 hrs. after shot _____

Gas _____ Cu. Ft.

Dry Hole _____

Abandoned _____

Date

APR 13 1938 19

H. D. Hatfield Scout