
FORM 51 5M 2-38 TPCO.

Stafford KANSAS

Section 12 Township 22 Range 13-W

Well No. 1 Walter Scheib

Company Stanolind

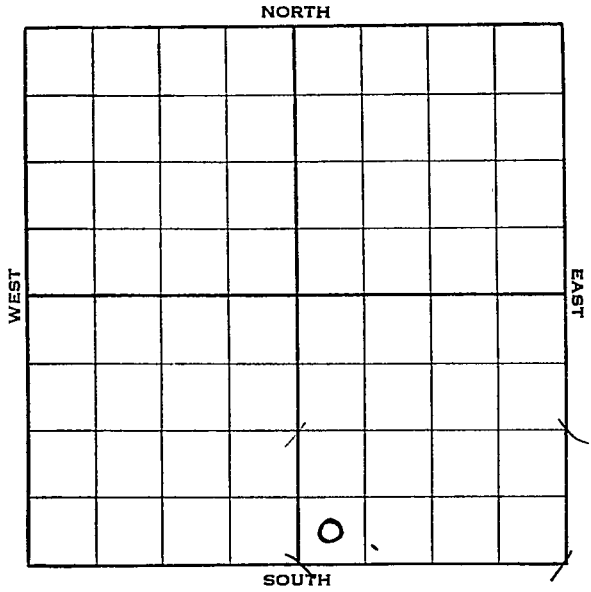


Form 252-A—5M—9-37 KANSAS Stafford

Sec. 12 Twp. 22 R. 13-W

Well No. #1 Walter Scheib Farm

Stanolind Company

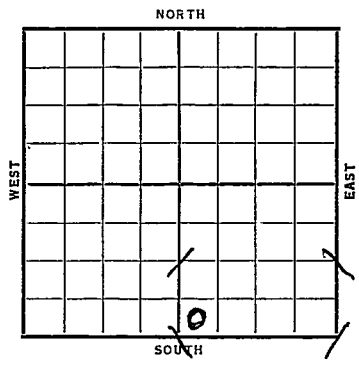

____ Ft. from N. Line

330 Ft. from S. Line

____ Ft. from E. Line

330 Ft. from W. Line

Elev. 1884

Date	REPORT
1938	
3/9	R U R
3/18	10" @ 255'. Anhy 730'.
	Drlg. 2170'.
3/25	Lans. 3345'. Drlg. 3630'.
4/1	Viola 3598'. Simp. sh. 3622'.
	Arb. 3675-79'. 6" @ 3675'.
	Drilled plug. 600' oil in 11
	hrs. Cored to T.D. 3682'.
	Sat. in core 3679-80'.
	3400' oil in 5 hrs.
4/6	6" @ 3675'.
	Arb. 3675'.
	T.D. 3682'.
	2000 acid.
	Potential 1859 bbls.
	COMPLETED

Form 26—1M Bks.—2-29 Stafford KANSAS

Map No. 82 Sec. 12 Twp. 22 R. 13W

Well No. 1 Walter Scheib

Stanolind Company

Contractor

FIRST REPORT

SW SE


_____ Ft. from N. Line

330 Ft. from S. Line

_____ Ft. from E. Line

330 Ft. from W. Line

SECTION PLAT

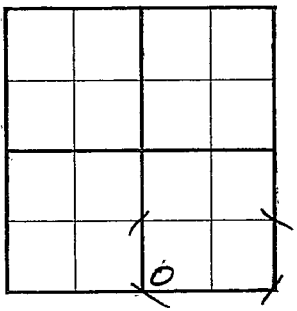

Location _____

Rig up _____

Drilling and Remarks:

RUR

RECORD

Cased _____ in., _____ ft.

Sand _____

Gas _____

Oil _____

Total Depth _____

PRODUCTION

1st 24 hrs. Nat. _____

1st 24 hrs. after shot _____

Gas _____ Cu. Ft.

Dry Hole _____

Abandoned _____

Date

MAR 9 - 1938 19 H. D. Hatfield Scout

Form 26—1M Bks.—2-29

Stafford KANSAS

Map No. 82 Sec. 12 Twp. 22 R. 13W

Well No. 1 Walter Scheib

Stanolind Company

Contractor

COMPLETED

SW SE


Ft. from N. Line

330 Ft. from S. Line

Ft. from E. Line

330 Ft. from W. Line

SECTION PLAT

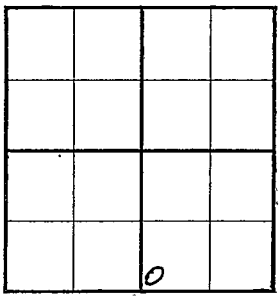

Location

Rig up

Drilling and Remarks:

3000 and

Pot 1859

RECORD

Cased 6 in., 3675 ft.

~~Sand~~ Arb 3675

Gas

Oil

Total Depth 3682

PRODUCTION

1st 24 hrs. Nat.

1st 24 hrs. after shot

Gas Cu. Ft.

Dry Hole

Abandoned

Date

APR 6 - 1938 19 H. D. Hatfield Scout