

KANSAS

Stafford

FORM 51 5M 4-41 PETROL


Section 12 Township 22 Range 13-W

Well No. #2 Scheid

Company Stanolind

Drach Pool

NORTH

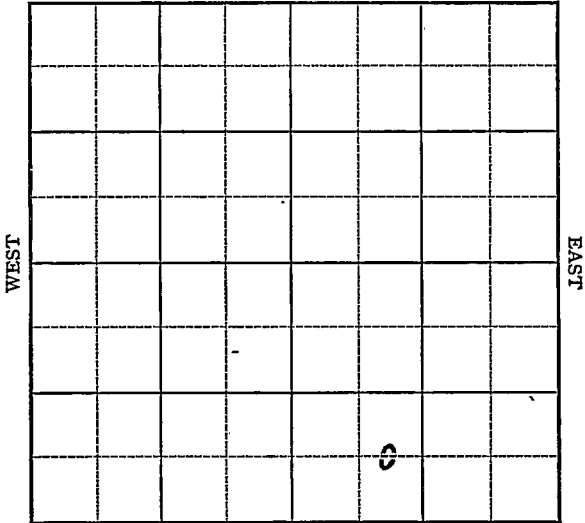

SOUTH

Sec. 12 Twp. 22 R. 13-W

Well No. #2 Scheid Farm

Stanolind Company

(Drach)


_____ Ft. from N. Line

660 Ft. from S. Line

_____ Ft. from E. Line

990 Ft. from W. Line

Elev. 1891

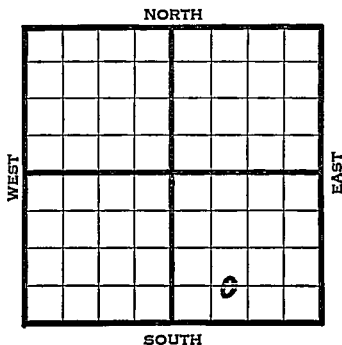

| 1941 | | REPORT |
|------|--|----------------------------|
| 4/9 | | Derrick. |
| 4/18 | | 8" - 245' Anhy 715' |
| | | Drlg. 1970' |
| 4/24 | | Lans. 3340' Viola 3588' |
| | | Simpson 3618' Drlg. 3671' |
| 5/1 | | Arb. 3676' 5" - 3677' |
| | | T.D. 3681' 500 acid. |
| 5/7 | | Arb. 3676' |
| | | 5" - 3677' |
| | | T.D. 3685' |
| | | 1500 acid. |
| | | Potential 267 bbls., pump. |
| | | 36.3 Gravity |
| | | COMPLETED |

Map No. 82 Sec. 12 Twp. 22 R. 13WWell No. 2 ScheidStanolind

Company

FIRST REPORT

Contractor

SECTION PLAT

C E L SW SE

 Ft. from N. Line660 Ft. from S. Line Ft. from E. Line990 Ft. from W. Line

DRACH POOL

| | | | |
|--|--|---|--|
| | | | |
| | | | |
| | | | |
| | | o | |

Location Rig up

Drilling and Remarks:

Derrick

RECORDCased in., ft.Sand Gas Oil Total Depth **PRODUCTION**1st 24 hrs. Nat. 1st 24 hrs. after shot Gas Cu. Ft.Dry Hole Abandoned

Date

APR 9 1941 19

S. J. LEWIS

Scout

Map No. 82 Sec. 12 Twp. 22 R. 13W

Well No. 2 Scheid

Stanolind Company

COMPLETED Contractor

SECTION PLAT

C E L S W S E

 Ft. from N. Line

660 Ft. from S. Line

 Ft. from E. Line

990 Ft. from W. Line

| | | | |
|--|--|--|--|
| | | | |
| | | | |
| | | | |
| | | | |
| | | | |

DRACH POOL

Location

Rig up

Drilling and Remarks:

Ar 3676.
5" @ 3677
1500 Acid
Pump 267 P & Y

3/6 2/8

RECORD

Cased in., ft.

Sand

Gas

Oil

Total Depth 3685

PRODUCTION

1st 24 hrs. Nat.

1st 24 hrs. after shot

Gas Cu. Ft.

Dry Hole

Abandoned

Date

MAY 7 1941

S. J. LEWIS

Scout