

KANSAS


FORM 51 5M PETROL

Stafford

Section 12 Township 22 Range 13-W


Well No. #1 Teichman

Company Davis-Child Motor

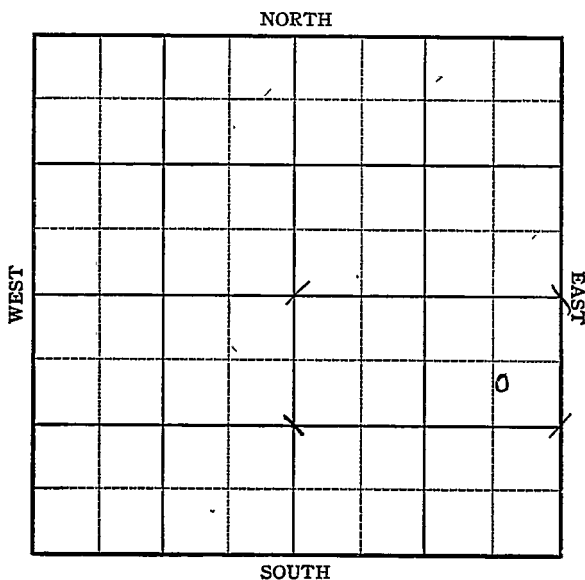

KANSAS

Stafford

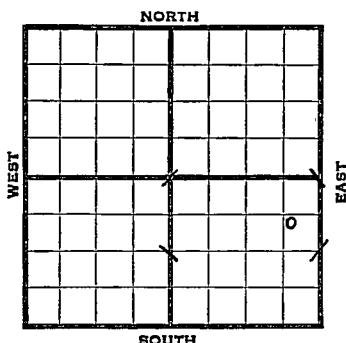Sec. 12 Twp. 22 R. 13-WWell No. #1 Teichman FarmDavis-Child Motor Company765 Ft. from N. Line Ft. from S. Line555 Ft. from E. Line Ft. from W. Line

1943

Elev. 1893

REPORT

9/1

10" @ 261'

Drlg. 2160'

9/8

Topeka 2900

Drlg. 3230

9/15

Lans 3358

Long 3587

Drlg. 3697

9/22

Arb 3685-87 T.D. SO

5" @ 3686'

Rust

9/29

Arb 3683 Corrected

5" @ 3683

T.D. 3686

3300' oil 11 hrs.

10/6

Swab 44 oil in 8 hrs.

10/13

" " " " "

10/20

" " " " "

10/27

" " " "

11/3

" " " "

11/10

" " " "

11/17

" " " "

OVER

1943

12-1

5" @ 3683

Arb 3683

TD 3686

Pump 310 Pot.

Gravity 37.2

COMPLETED

KANSAS

Map No. 82 Sec. 12 Twp. 22 R. 13WWell No. 1 TeichmanDavis-Child Motor Company

FIRST REPORT

Contractor

C NE SE

765 Ft. from N. Line Ft. from S. Line555 Ft. from E. Line Ft. from W. Line

SECTION PLAT

			0

Drach PoolLocation Rig up

Drilling and Remarks:

10" - 2612160 Drill

RECORD

Cased in., ft.Sand Gas Oil Total Depth

PRODUCTION

1st 24 hrs. Nat. 1st 24 hrs. after shot Gas Cu. Ft.Dry Hole Abandoned

Date

SEP 1 1943 19S. J. LEWIS Scout

Stafford

KANSAS

Map No. 82 Sec. 12 Twp. 22 R. 13WWell No. 1 TeichmanDavis-Child Motor Company

COMPLETED

Contractor

C NE SE

SECTION PLAT

			6

765 Ft. from N. Line Ft. from S. Line555 Ft. from E. Line Ft. from W. Line

Drach Pool

Location Rig up

Drilling and Remarks:

*CR 83683**5' 103683**Prod 30/104.**37 1/2*

RECORD

Cased in., ft.Sand Gas Oil Total Depth 267 1/2

PRODUCTION

1st 24 hrs. Nat. 1st 24 hrs. after shot Gas Cu. Ft.Dry Hole Abandoned

Date

DEC 1 1943 19

S. J. LEWIS Scout