Form 51-5M 5-37 Petrol

Stafford KANSAS

Section 12 Township 22 Range 13-W

Well No. #1 G.A. Schilling

Company Stanolind

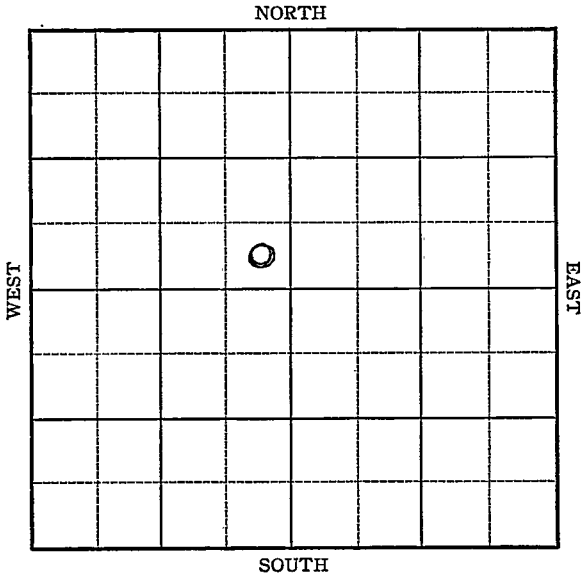

Form 252-A—5M—9-37 KANSAS Stafford

Sec. 12 Twp. 22 R. 13 W

Well No. #1 G. A. Schilling Farm

Stanolind Company

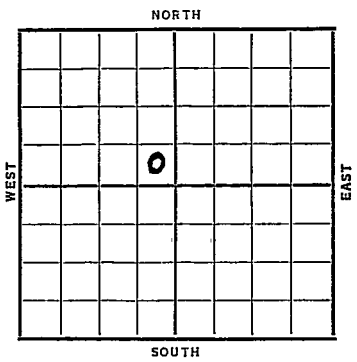

____ Ft. from N. Line

330 Ft. from S. Line

330 Ft. from E. Line

____ Ft. from W. Line

Elev. 1887

Date	REPORT
1937	
11/17	Cellar.
11/26	R. R.
12/3	13" @ 251'. WOC.
12/10	Anhy 715'. Drlg. 2660'.
12/17	Topeka 2946'. K.C. 3375'.
	Viola 3620'. Drlg. 3631'.
	No shows.
12/24	Simp. 3650'. S.O. 3695-3703'.
	Sil. 3703 & 7".
	Sat. 3704-08'. RUST.
12/31	" " " "
1938	
1/7	T.D. 3716'. 20 qts. 3706-12'.
	400' oil. Clean out.
1/14	1700 acid. 500' oil.
	T.D. 3716'.
1/20	3000 acid swb 4 bbls oil p.h.
1/28	Pot. 47 oil & 10% water
	Will Retake.
2/4	" " "

OVER

1938

2/9 7" @ 3703'.

Arb. 3703'.

T.D. 3716'.

Pumps 2 oil & 2½ water per hour.

15 bbls.

Minimum well.

COMPLETED

Form 26—1M Bks.—2-29

Stafford KANSAS

Map No. 82 Sec. 12 Twp. 22 R. 13W

Well No. 1 G. A. Schilling

Stanolind Company

Contractor

FIRST REPORT

SE NW

_____ Ft. from N. Line

330 Ft. from S. Line

330 Ft. from E. Line

_____ Ft. from W. Line

SECTION PLAT

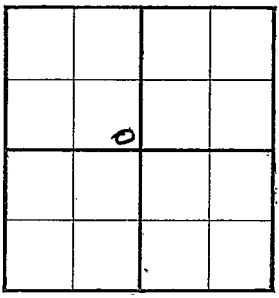

Location _____

Rig up _____

Drilling and Remarks:

Cellar.

RECORD

Cased _____ in., _____ ft.

Sand _____

Gas _____

Oil _____

Total Depth _____

PRODUCTION

1st 24 hrs. Nat. _____

1st 24 hrs. after shot _____

Gas _____ Cu. Ft.

Dry Hole _____

Abandoned _____

Date

NOV 17 1937 19 H. D. Hatfield Scout

Form 26—1M Bks.—2-29 Stafford KANSAS

Map No. 82 Sec. 12 Twp. 22 R. 13W

Well No. 1 G. A. Schilling

Stanolind Company

Contractor

COMPLETED

SE NW

____ Ft. from N. Line

330 Ft. from S. Line

330 Ft. from E. Line

____ Ft. from W. Line

SECTION PLAT

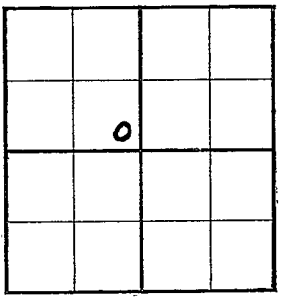

Location ____

Rig up ____

Drilling and Remarks:

Pumped 2 oil & 2½ water per hour

15-bbl Minimum well

RECORD

Cased 7 in., 3703 ft.

~~Sand~~ Arb 3703

Gas ____

Oil ____

Total Depth 3716

PRODUCTION

1st 24 hrs. Nat. ____

1st 24 hrs. after shot ____

Gas ____ Cu. Ft.

Dry Hole ____

Abandoned ____

Date

FEB 9 1938 19 H. D. Hatfield Scout