

# KANSAS


FORM 51 5M 6-46 PETROL

Stafford

Section 12 Township 22 Range 13W

Well No. 3 Teichmann

Company Davis & Child

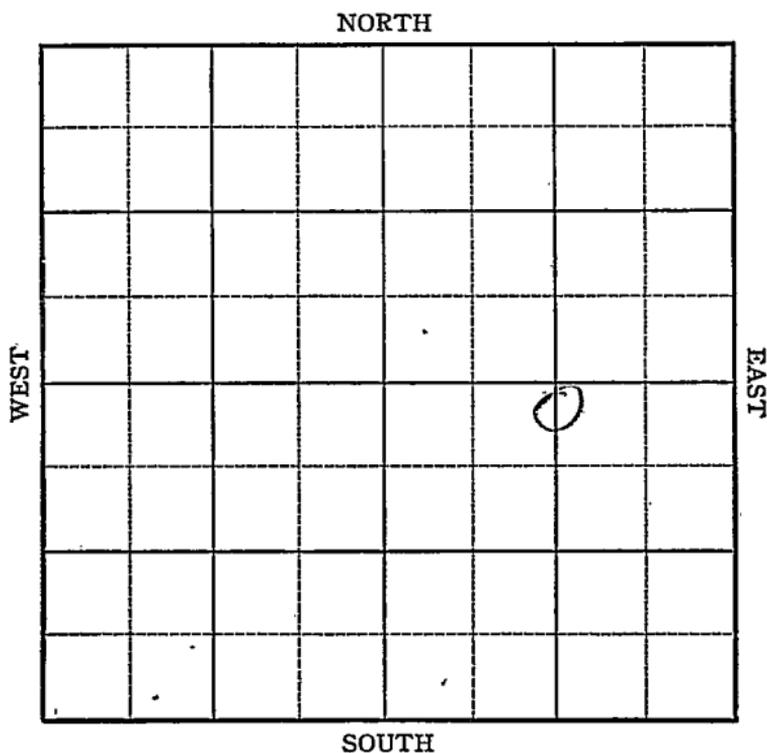

Sec. 12 Twp. 22 R. 13W

Well No. #3 Teichmann Farm

Davis & Child Company

Drach


430 Ft. from N. Line

\_\_\_\_\_ Ft. from S. Line

\_\_\_\_\_ Ft. from E. Line

1290 Ft. from W. Line

CNL SE

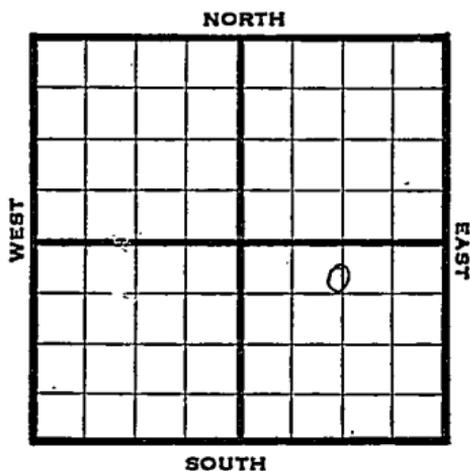

1946 *1888* Elev. REPORT

7/3 10" @ 280  
Drlg. 3050'

7/9 Lans 3327  
Cong 3553  
Viola 3559  
Simp 3602  
Arb 3658  
5" @ 3655  
TD 3676', RUST

7/16 " "

7/23 " "

7/30 3300' oil 1 1/2 hrs

8/6 " "

8/14 Arb. 3658  
5" @ 3655  
TD 3676'  
Echo Pot. 8008 No. W.  
Max. 3000  
Grav. 39.9

COMPLETED

KANSAS Pool Name Drach

Map No. 82 Sec. 12 Twp. 22 R. 13W

Well No. 3 Teichmann

Davis & Child Company

FIRST REPORT Contractor

C N L SE


SECTION PLAT

430 Ft. from N. Line

\_\_\_\_\_ Ft. from S. Line

\_\_\_\_\_ Ft. from E. Line

1290 Ft. from W. Line

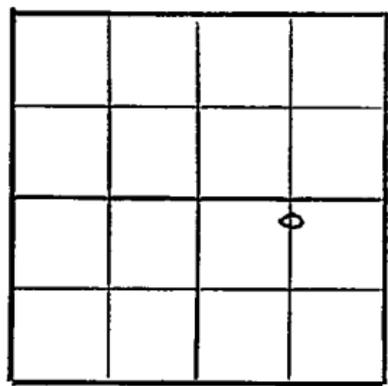

Stafford

Location \_\_\_\_\_

Rig up \_\_\_\_\_

Drilling and Remarks:  
10" @ 280'  
3050'

RECORD

Cased \_\_\_\_\_ in., \_\_\_\_\_ ft.

Sand \_\_\_\_\_

Gas \_\_\_\_\_

Oil \_\_\_\_\_

Total Depth \_\_\_\_\_

PRODUCTION

1st 24 hrs. Nat. \_\_\_\_\_

1st 24 hrs. after shot \_\_\_\_\_

Gas \_\_\_\_\_ Cu. Ft.

Dry Hole \_\_\_\_\_

Abandoned \_\_\_\_\_

Date

JUL 3 1946 19

S. J. LEWIS Scout

**KANSAS**

Kansas Pool Name Drach Pool

Map No. 8 Sec. 12 Twp. 22 R. 13W

Well No. 3 Teichmann

Davis & Child Company

**COMPLETED**

C N L SE

Contractor

*E. J. 1946*


**SECTION PLAT**

430 Ft. from N. Line

\_\_\_\_\_ Ft. from S. Line

\_\_\_\_\_ Ft. from E. Line

1290 Ft. from W. Line

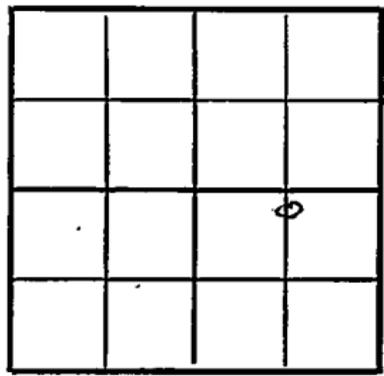

Stafford County

Location \_\_\_\_\_

Rig up \_\_\_\_\_

Drilling and Remarks:

*Core 3658*  
*511 @ 3658*  
*Echo Prod.*  
*8008 NW*  
*Map 3000*  
*3926*

**RECORD**

Cased \_\_\_\_\_ in., \_\_\_\_\_ ft.

Sand \_\_\_\_\_

Gas \_\_\_\_\_

Oil \_\_\_\_\_

Total Depth 3676

**PRODUCTION**

1st 24 hrs. Nat. \_\_\_\_\_

1st 24 hrs. after shot \_\_\_\_\_

Gas \_\_\_\_\_ Cu. Ft.

Dry Hole \_\_\_\_\_

Abandoned \_\_\_\_\_

Date

AUG 1. 4 1946 19

S. J. LEWIS Scout