

KANSAS


 Stafford

Section 12 Township 22 Range 13W

Well No. 4 Teichmann

Company Davis-Childs

Drach Pool
NORTH

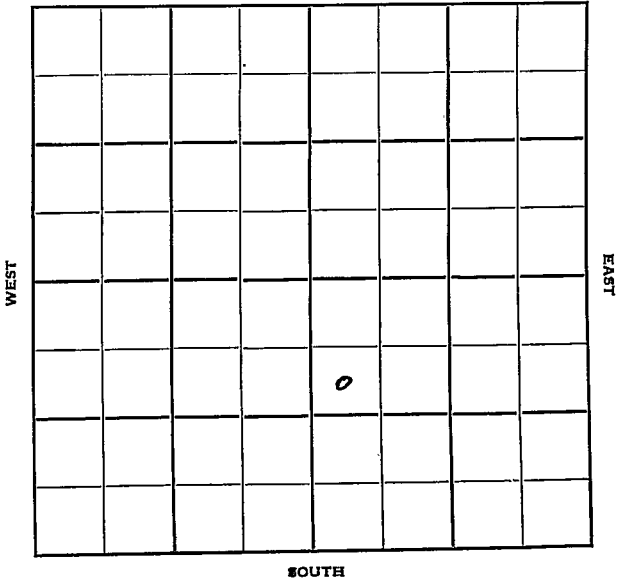

KANSAS

Stafford

Sec. 12 Twp. 22 R. 13W ✓

Well No. #4 Teichmann Farm

Davis - Childs Company


Drach Pool

990' Ft. from N. Line

_____ Ft. from S. Line

_____ Ft. from E. Line

330' Ft. from W. Line

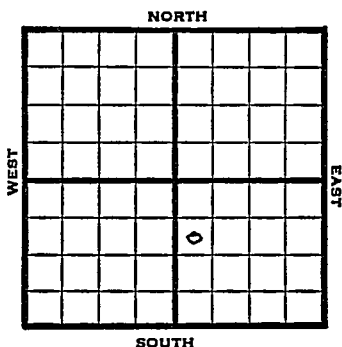

SW NW SE

1949 Elev 1885' REPORT

- 5/4 Location
- 5/10 "
- 5/18 8" @ 320'
- Drlg 2000'
- 5/25 Lansing 3338'
- Viola 3580'
- Simpson Dolo 3615'
- TD 3678'
- 5" @ 3676'
- 6/1 "
- 6/7 W
- 6/15 Simp 3615'
- 5" @ 3676'
- TD 3680'
- Pump 75 Oil Pot
- 39° Gr.
- Comp

COMPLETED

Kansas

Map No. _____ Sec. 12 Twp. 22 R. 13WWell No. 4 TeichmannDavis - Childs Company**FIRST REPORT** Contractor

SW NW SE

SECTION PLAT

990 Ft. from N. Line

_____ Ft. from S. Line

_____ Ft. from E. Line

330 Ft. from W. Line

Stafford CountyLocation X

Rig up _____

Drilling and Remarks:

RECORD

Cased _____ in., _____ ft.

Sand _____

Gas _____

Oil _____

Total Depth _____

PRODUCTION

1st 24 hrs. Nat. _____

1st 24 hrs. after shot _____

Gas _____ Cu. Ft.

Dry Hole _____

Abandoned _____

Date

MAY 4 1949 19S. J. LEWIS Scout

Stafford County Kansas State

Map No. 1K82 Sec. 12 Twp. 22 R. 13W

Well No. 4 Teichmann

Davis - Childs Company

COMPLETE

Contractor

SW NW SE

E. 1985
SECTION PLAT

990 Ft. from N. Line

_____ Ft. from S. Line

_____ Ft. from E. Line

330 Ft. from W. Line

Drach Pool

Remarks:

Sing 3615

5" @ 3676

MD 3680

Imp 25 oil Port

39° 42'

Date
JUN 15 1949

Scout