

Section 12 Township 22 Range 11W

Well No. #1 Williams

Company Westgate Greenland

NORTH

	0						

WEST

EAST

SOUTH

Sec. 12 Twp. 22 R. 11W

Well No. #1 Williams Farm

Westgate Greenland Company

Jackson Contractor

Semi Wildcat

NORTH

330 Ft. from N. Line


_____ Ft. from S. Line

_____ Ft. from E. Line

330

_____ Ft. from W. Line

NW NW NW

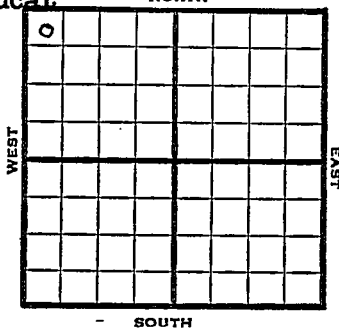

1952 Elev. 1932' REPORT

1/30 RUR
2/6 8" @ 332 Anhy 802 Heeb. 3272
Br Li 3395 Lans. 3408
Drilg. 3466'

2/13 Simp 3694' Arb. 3744'
DST 3743-58', 1 hr, 1380' gas, 1255'
gassy oil. TD 3796' 5" @ 3796'

2/20 48/ 3748-60 S/ 8 boph nat. POP

3/5 Pumping
3/12 "
3/19 Spud 1-28-52
Oil well TD 3796'
8" @ 332' Anhy 802' Heeb 3272'
Br. line 3395', Lans 3408'
DST 3445-82 open 1 hr, rec 90' OGM,
180' HOCM.
DST 3524-37, open 1 hr, gas in 35 min.
rec 150' oil, 35' HO & GCM
DST 3545-75 open 1 1/2 hr. rec 180' O &
GCM. B KC 3630' Viola 3662'
Simp. 3694', Arb. 3744'
DST 3743-58 open 1 hr. rec 1380' gas,
1255' gassy oil. TD 3796' 5" @3796
48/3748-60 S/8 BOPH
Comp. 330 BOPD

COMPLETED


County Stafford State Kansas

Sec. 12 (Blk. 22) (Sur. 14W) Map No.

Operator Westgate Greenland

Well No. 1 Farm Williams

Elev. _____ Location NW NW NW

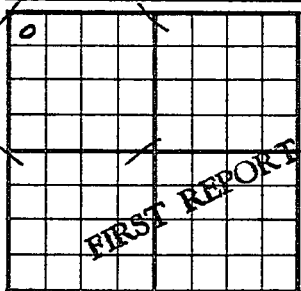

330 Ft. From N Line NW

330 Ft. From W Line Quarter

Ist. Report JAN 30 1952

Completion _____

Remarks _____

Jackson - Contr.

Spudding Date _____


Drlg. Data _____

Semi Wildcat

RUR

J. G. McGEHEE

County Stafford State Kansas
 Sec. 12 (Blk. Twp.) 22 (Sur. Rge.) 14W Map No.
 Operator Westgate-Greenland
 Well No. 1 Farm Williams
 Elev. 1932 Location NW NW NW

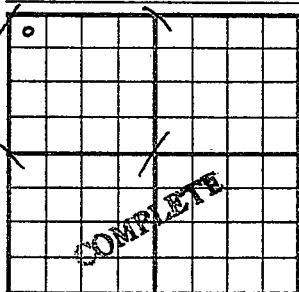330 Ft. From N Line NW330 Ft. From W Line Quarter

1st. Report

Completion MAR 19 1952Remarks Semi WildcatJackson Drlg. - Contr.Spudding Date 1-28-52Drlg. Data Oil well TD 37968" @ 332 Anhy 802 Heeb. 3272Br. lime 3395 Lans. 3408 DST 3445-82open 1 hr. Rec. 90' ocm 180' hocmDST 3524-37 open 1 hr. gas in 35 min.Rec. 150' oil 35' ho & gcm DST 3545-75open 1 $\frac{1}{2}$ hr. Rec. 180' o & gcmB KC 3630 Viola 3662 Simp. 3694Arb. 3744 DST 3743-58 open 1 hr.Rec. 1380' gas 1255' gassy oilTD 3796 5" @ 3796 48/ 3748-60S/ 8 boph Comp. 330 bopd

J. G. McGEHEE