


DX 78-1 Stafford

KANSAS

Section 12 Township 22 Range 11W

Well No. #3 Roach

Company Thomas H. Allan & CRA

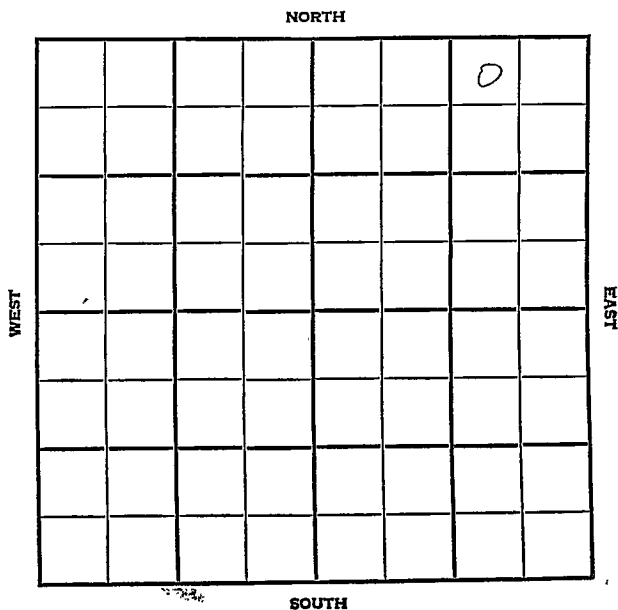

Stafford

SEC.	TWP.	R.
12	22	14W

WELL NO.

#3 Roach

FARM

COMPANY

Thomas H. Allan & CRA

CONTRACTOR

Co. Tools

Curtis


_____ FT. FROM N. LINE

_____ FT. FROM S. LINE

_____ FT. FROM E. LINE

_____ FT. FROM W. LINE

NW NE NE

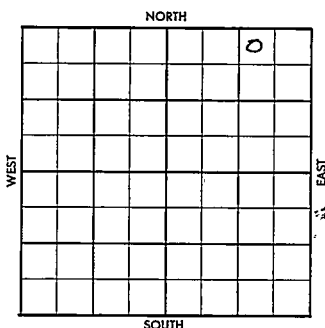

	ELEVATION	REPORT
1956	1926';	

7-25 Comm. 7-19-56
8" @ 295 w/200
Drlg. 1815'

8-15 DST 3508-28 op 1 hr., 510' gas, rec.
30' HOCM, BHP 232/20".
DST 3543-68 op 48 min. rec. 210' SO&GC
M, 1098/20".
5 1/2" @ 3709 1/2 w/100
DD 3712
DD 3714; FU 800' oil, 50 acid;
S/ 11 boph,
P/ 25 bopd, no/wtr.
Anh. 790'; H. 3260'; BL. 3382';
L. 3396'; A. 3706'
TD 3710'

COMPLETED

County Stafford Elev. _____
 Sec. 12 Twp. 12S Rge. 11W
 Company Thomas W. Allen & CRA
 Farm Name Roach No. 3

TOPS	DEPTH	LOG	DATUM	Loc. in Sec.
Anh.				NW NE NE
TP.				
H.				
Tr.				
Dg.				
BL.				
L.				Geol.
K.C.				Contr.
B.K.C.				Co. tools
Ce.				Pool
C.				Gurtis
M.				
M.				
K.				
Mz.				
Mo.				
V.				
S.				
S.				
A.				
R.				
Pe.				
G.				
T.D.				

			0
JUL	25	1956	
FIRST REPORT			

Date Comm. 7-19-56
 8" @ 295/200 drlg. 1815

2221 I 20A

County

Elev.

Sec.

Twp.

Rge.

Company

FarmName

No.

TOPS	DEPTH	LOG	DATUM	Loc. in Sec.
Anh.	790			
T.P.				
H.	3260			1200 E
Tr.				
Dg.				
BL.	3382			
L.	3396			
K.C.				Geol.
B.K.C.				Contr.
Ce.				
C.				
M.				Pool
M.				
K.				
Mz.				
Me.				
V.				
S.				
S.				
A.	3706			
R.				
PE.				
G.				
TD.	3710			

COMPLETE

Date Comm.

AUG 15 '56

295/20

AUG 1 '56

DST 3508-28 1hr 510' 900 rev

30' HOCM BHP 232/20" DST

3543-68 rev 48" rev 210'

50 & GCM 1098/20" 5 1/2 @ 3709 1/2

1100 WOCT AUG 8 '56 CO DD 3712

50 DD 3714 TD FU 800' 01'

50 acid & 11 Buph POP

AUG 15 '56

P. 25 Bopd no/w