


KANSAS

Section 12 Township 22 Range 11 W

Well No. # 1 Roach - Wilson

Company Westgate-Greenland

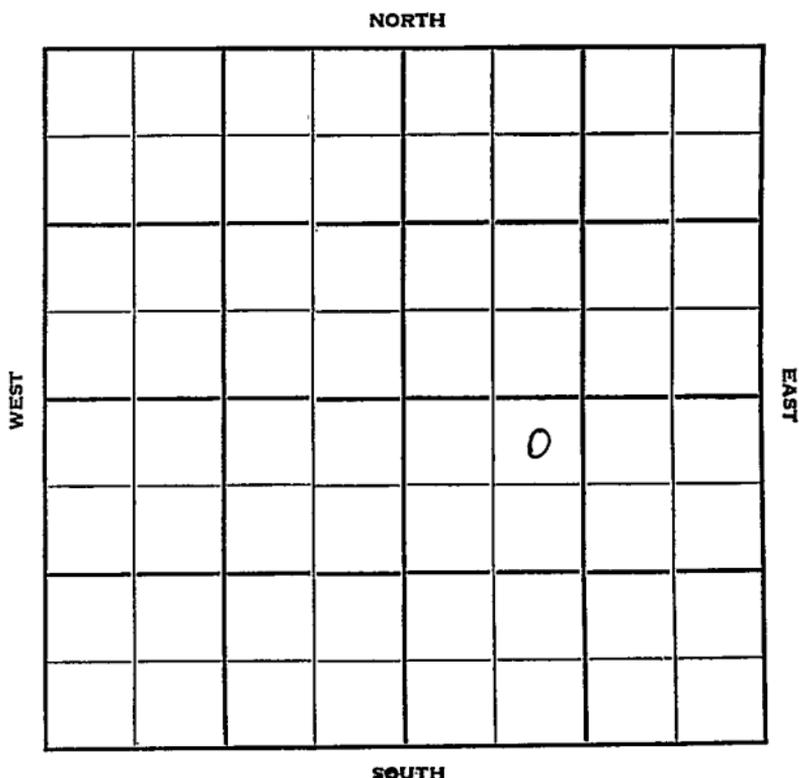

Sec. 12 Twp. 22 R. 14 W

Well No. # I Roach - Wilson Farm

Westgate Greenland Company

Contractor

Curtis Pool


330 Ft. from N. Line

Ft. from S. Line

Ft. from E. Line

990 Ft. from W. Line

NE NW SE

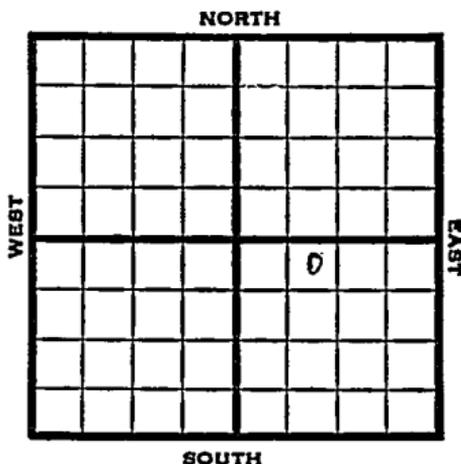

1951

Elev. 1932' REPORT

7/11

Spud 7-6-51

8" @ 350

Anhy 800'

Drlg. 2100'

10/24

Spud 7-6-51

8" @ 350

Anhy 800 Heeb. 3282

Br. 1m. 3408 Lans. 3418

DST 3475-93 open 1 hr.

Rec. 110' O&GCM

DST 3535-46 open 1 hr.

Rec. 30' SOCM

DST 3551-77 open 1 hr.

Rec. 10' OCM

B KC 3658 Viola 3677

Simp. 3698 Arb. 3751

DST 3747-58 open 1 hr.

Rec. 310' fluid (200' was oil)

DST 3761-76 open 1 hr.

Rec. 1560' oil TD 3791

5" @ 3791 72/ 3751-73

S/ 30 BO 7 hr.

Comp. 42 BOPD 13% wtr.

3418
1732
- 1486

3751
1432
- 1419

COMPLETED

County Stafford State Kansas

Sec. 12 (Blk. Twp.) 22 (Sur. Rge.) 14 W Map No.

Operator Westgate Greenland

Well No. 1 Farm Roach - Wilson

Elev. 1932 Location NE NW SE

FIRST REPORT
0

330 Ft. From N Line SE
990 Ft. From W Line Quarter

Ist. Report JUL 11 1951

Completion _____

Remarks _____

Spudding Date 7-6-51

Drig. Data Curtis - pool

8" @ 350 anhy 800 Drig. 2100

J. E. TYRA

