

Section 12 ~~28~~ Township 22 Range 14 W

Well No. # 2 Williams (A)

Company Westgate-Greenland

NORTH

0							

WEST

EAST

SOUTH

Sec. 13 Twp. 22 R. 14W

Well No. #2 Williams (A) Farm

Westgate-Greenland Company

Jackson- Contr. Contractor


990' Ft. from N. Line

..... Ft. from S. Line

..... Ft. from E. Line

330' Ft. from W. Line

SW NW NW

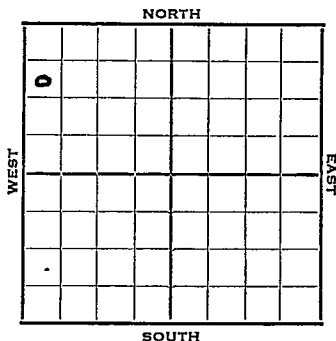

1952 Elev. 1934 REPORT

6/18	Spud 6-11-52 10" @ 330 Anhy 801 Drlg. 2394'
6/25	Heeb. 3276 Br Li 3399 Lans. 3410 DST 3475-3507, 1 hr. 160' m SSO 1100# DST 3526-40, 1 hr. gas in 14" 20' HO&GCM 450' free oil 900# DST 3546-79, 1 hr. 35' m VSSO 640# B KC 3631 V. 3668 Drlg. 3710'
7/2	Simp. 3703' Arb. 3749' DST 3750-63, 1 hr, 655' gassy oil, 1200# RTD 3789' 7" @ 3788 WOCT
7/9	DP 3770' 45/3752-63 S/5 BOPH set plug. 3555' Perf/3526-40 S/1 1/2 BOPH 1000 A S/90 BO 3 hrs.
7/17	NR
7/23	"
7/30	"206 Bopd
8/6	NR

OVER

Map No. _____ Sec. 12 Twp. 22 R. 14W

Well No. 2 Williams (A)

Westgate-Greenland Company

CORRECTION

Contractor

SW NW NW

SECTION PLAT

990 Ft. from N. Line

_____ Ft. from S. Line

_____ Ft. from E. Line

330 Ft. from W. Line

o			

Location _____

Rig up _____

Drilling and Remarks:

Reported

Sec. 13-22-14W

RECORD

Cased _____ in., _____ ft.

Sand _____

Gas _____

Oil _____

Total Depth _____

PRODUCTION

1st 24 hrs. Nat. _____

1st 24 hrs. after shot _____

Gas _____ Cu. Ft.

Dry Hole _____

Abandoned _____

Date

JUN 25 1952 19

J. G. MCGEE

Scout

County Stafford State Kansas
 Sec. 12 (Blk. 22 (Sur. 14W (Twp.) (Rge.) Map No.
 Operator Westgate-Greenland
 Well No. 2 Farm Williams "A"
 Elev. 1934 Location SW NW NW

o					

990 Ft. From N Line NW

330 Ft. From W Line Quarter

1st. Report

Completion AUG 13 1952

Remarks

Jackson Drlg. - Contr.Spudding Date 6-11-52Drlg. Data Oil well TD 378910" @ 330 Anhy 801 Heeb. 3276Br. lime 3399 Lans. 3410 DST 3475-3507open 1 hr. Rec. 160' mud SSO 1100#DST 3526-40 open 1 hr. gas in 14 min.Rec. 20' ho & gcm 450' free oil 900#DST 3546-79 open 1 hr. Rec. 35' mudVSSO 640# B KC 3631 Viola 3668Simp. 3703 Arb. 3749 DST 3750-63open 1 hr. Rec. 655' gassy oil 1200#TD 3789 7" @ 3788 DP to 3770 45/ 3752-63 S/ 5 boph SP 3555 Perf/ 3526-40S/ 1½ boph 1000 A S/ 90 bo 3 hr.Comp. 481 bopd

J. G. McGEHEE

1952

8/13 Spud 6-11-52 Oil Well TD 3789
10" @ 330 Anhy 801 Heeb. 3276
Br Lime 3399 Lans. 3410
DST 3475-3507 opn 1 hr. Rec. 160' mud
SSO 1100#
DST 3526-40 opn 1 hr. gas in 14 min.
Rec. 20' ho & gcm 450' free oil
900#
DST 3546-79 opn 1 hr. Rec. 35' mud
VSSO 640# BKC 3631 Viola 3668
Simp. 3703 Arb. 3749
DST 3750-63 opn 1 hr. Rec. 655' gassy
oil 1200# TD 3789 7" @ 3788
DP to 3770 45/3752-63 S/5 boph
SP 3555 Perf 3526-40 S/1½ boph
1000 A S/90 bo 3 hr.
Comp. 481 bopd

COMPLETED