


DX 78-1 Stafford

KANSAS

Section 12 Township 22S Range 14W

Well No. #4 Roach "A"

Company Tom Allen & C. R. A.

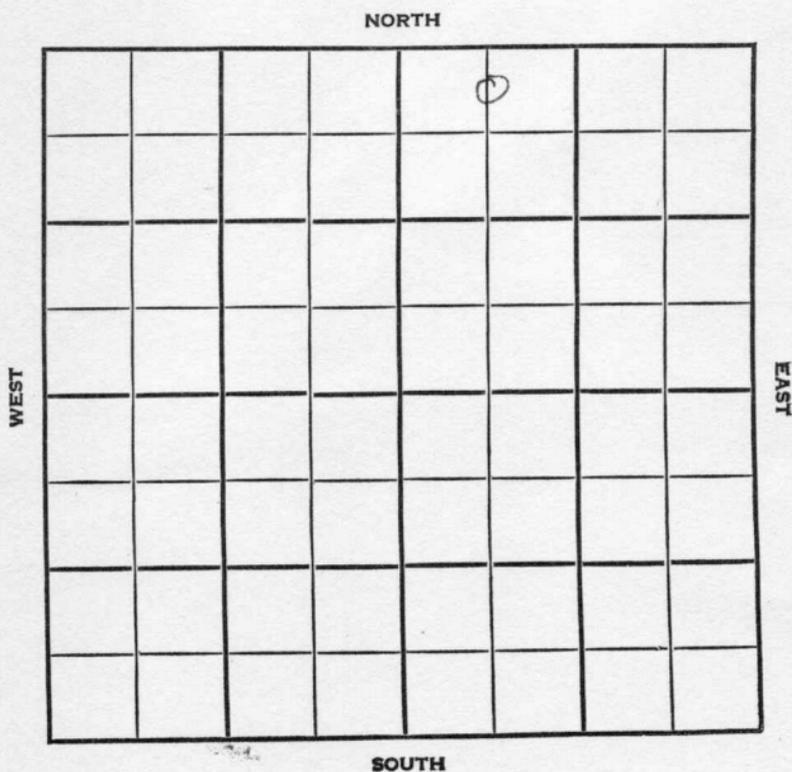

Stafford

KANSAS

SEC. 12	TWP. 22	R. 14W
------------	------------	-----------

WELL NO. #4 Roach #A" FARM

COMPANY Tom Allen & CRA

CONTRACTOR Allen

Curtis


_____ FT. FROM N. LINE

_____ FT. FROM S. LINE

_____ FT. FROM E. LINE

_____ FT. FROM W. LINE

C N $\frac{1}{2}$ NW NE

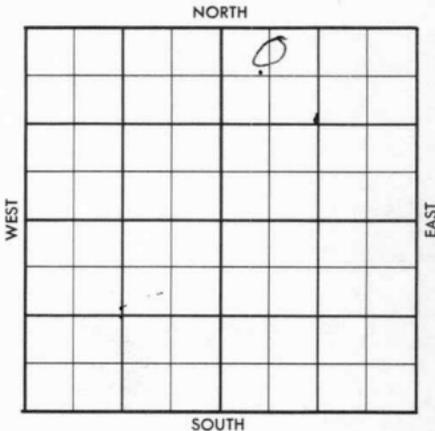

1956	ELEVATION	REPORT
------	-----------	--------

8-8	MIRT	
-----	------	--

County Stafford Elev. _____
 Sec. 12 Twp. 225 Rge. 14W
 Company Tom Allen & C. R. A.
 Farm Name Roach "A" No. 4

TOPS	DEPTH	LOG	DATUM	Loc. in Sec.
Anh.				C N $\frac{1}{2}$ NW NE
Tp.				
H.				
Tr.				
Dg.				
Bl.				
L.				Geol. _____
K.C.				Contr. _____
B.K.C.				
Ce.				<u>Allen</u>
C.				
M.				Pool _____
M.				<u>Curtis</u>
K.				
Mz.				
Me.				
V.				
S.				
S.				
A.				
R.				
Pe.				
G.				
T.D.				



Date Comm. MIRT AUG 8 '56

AUG 1 9 1956

R. G.

Co.
Lse.
No.
Sec.
T.
R.

County Stafford Elev. 1926
 Sec. 12 Twp. 22S Rge. 14W
 Company Tom Allen & C. R. A.
 FarmName Roach "A" No. 4

TOPS	DEPTH	LOG	DATUM	Loc. in Sec.									
Anh	<u>792</u>			<u>C N 1/2 NW NE</u>									
Tr.													
H.	<u>3270</u>			<u>450 NL</u>									
Tr.													
Dg.				Geol.									
Bl.	<u>3393</u>												
L.	<u>3406</u>			Contr									
K.C.													
B.K.C.				<u>Allen</u>									
Ce.													
C.	<u>suey</u>	<u>3658</u>		Pool									
M.													
M.				<u>Curtis</u>									
K.													
Mz.				<table border="1"> <tr> <td></td> <td><u>0</u></td> <td></td> </tr> <tr> <td></td> <td><u>OCT 24 '56</u></td> <td></td> </tr> <tr> <td colspan="3" style="text-align: center;">COMPLETE</td> </tr> </table>		<u>0</u>			<u>OCT 24 '56</u>		COMPLETE		
	<u>0</u>												
	<u>OCT 24 '56</u>												
COMPLETE													
V.													
S.	<u>3665</u>												
S.													
A.	<u>3711</u>												
R.													
PE.													
G.													
TD.	<u>3714</u>												

Date Comm. MIRT AUG 15 '56 F-9-56 85/8
364/225 AUG 22 '56 AUG 29 '56 SEP 5 '56
2130 SEP 12 '56 DST 3430-42
1hr 1830' gas + 150' SD GCM
585/20" SD @ 3580 SEP 19 '56
DST 3554-76 1hr 80' Md (USSC)
1089/30" 5 1/2 set. SEP 26 '56 5 1/2 @
3714/100 DD 3723 TD FU
2500' oil no/w 10 hrs. \$ 14

Bopk no/w T&R OCT 10 '56
 OCT 3 '56 OCT 17 '56 P. 75 Bo no/w
 24 hrs est P. 25 Bopd
 + Tr. wtu OCT 24 '56 est P. 25
 Bopd + Tr. wtu.

12-22-14

Cm/2 sw me