


Section 12 Township 22 Range 14 W

Well No. # 1 Roach Wilson

Company Monhart-Millison & Beebe

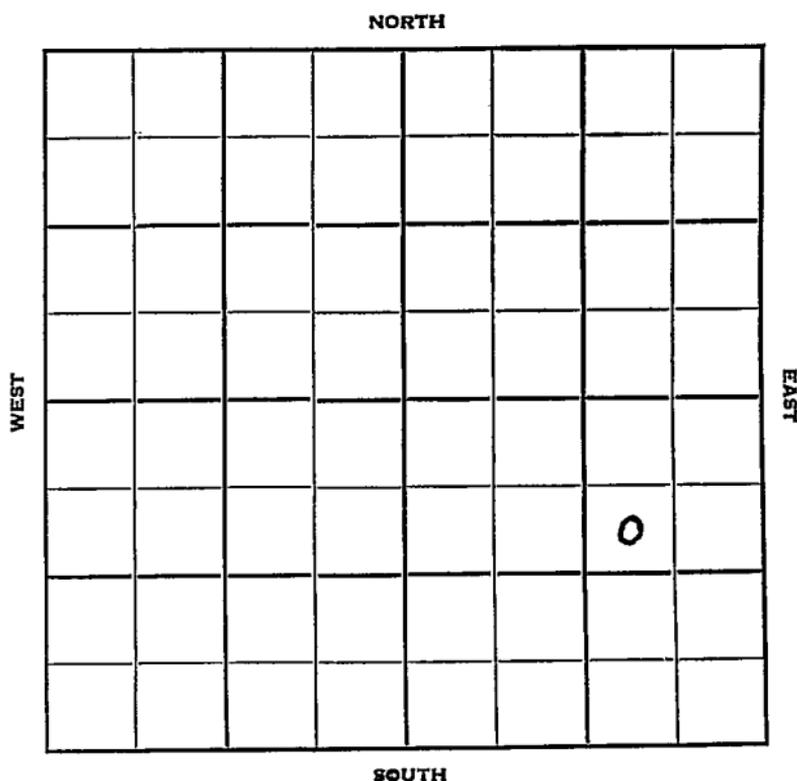

Sec. 12 Twp. 22 R. 14 W

Well No. # 1 Roach Wilson Farm

Monhart Millison & Beebe Company

B & B Drlg. Contractor

Curtis Pool


990 Ft. from N. Line

_____ Ft. from S. Line

990 Ft. from E. Line

_____ Ft. from W. Line

SW NE SE

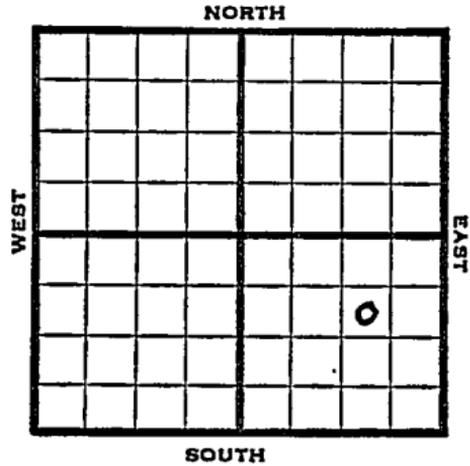

1952 Elev. 1924 REPORT

6/4 Spud 5-26-52
10" @ 308'
Drlg. 2960'

6/11 Br Li 3402 Lans. 3412
DST 3533-41, 1/2 hr. 30' m
V 3681 Simp. 3698
DST 3680-3700, 1 hr. 40' m
DST 3758-65'

6/18 Spud 5-26-52
D&A TD 3767
10" @ 308 Br Lime 3402 Lans. 3412
DST 3533-41 opn 1/2 hr. Rec. 30' mud
Viola 3681 Simp 3698
DST 3680-3700 opn 1 hr. Rec. 40' mud
DST 3758-65 opn 1/2 hr. Rec. 15' mud
Arb. 3755 TD 3767 D&A

ABANDONED

