


Section 12 Township 22 Range 11W

Well No. #2 Williams

Company Shell Oil Company

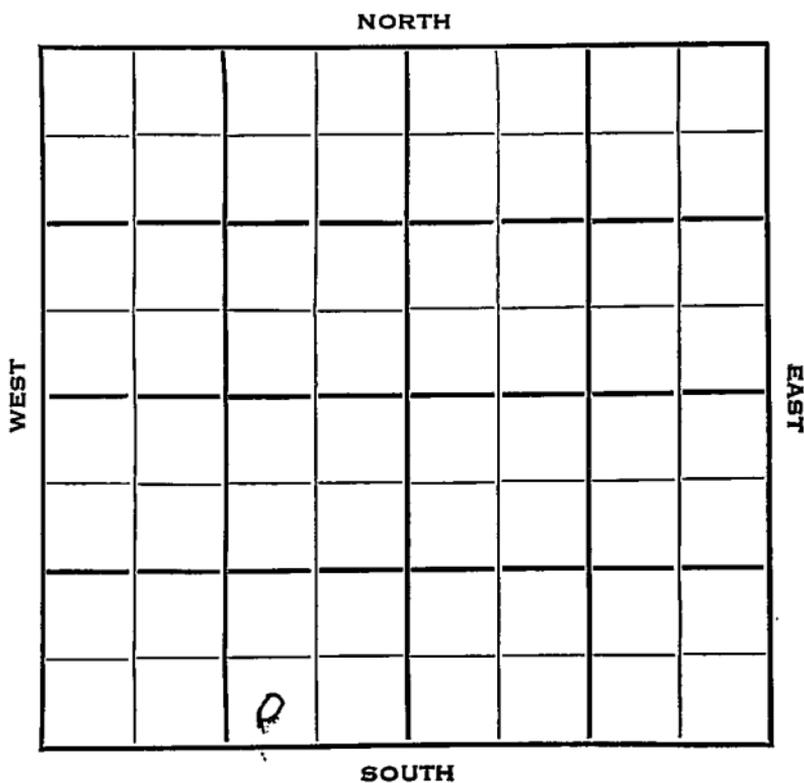

Stafford

ANASAS ✓

Sec. 12 Twp. 22 R. 14W

Well No. #2 Williams Farm

Shell Oil Company Company

Deek Drlg. - Contr. Contractor


N. Oscar Pool

_____ Ft. from N. Line

330 Ft. from S. Line

990 Ft. from E. Line

_____ Ft. from W. Line

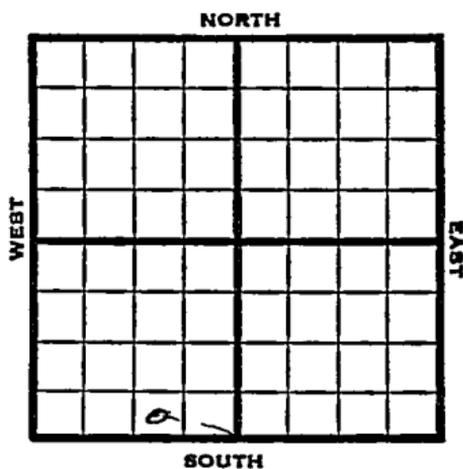

SW SE SW

1953 Elev. 1925' REPORT

3/4 Spudded 2/28/53
8" @ 795 Drlg. 1100

3/12 Drlg. 3517'

3/19 Lans 3402, Marm 3620, V 3658,
Simp 3677, Arb 3723
RTD 3814
5" @ 3813'

3/26 Testing

4/1 Spud 2-28-53
Oil well TD 3814 8" @ 795
Lans. 3402 Marm 3620 Viola 3658
Simp. 3677 Arb. 3723
TD 3814 5" @ 3813 4/3764-65
8 GO 20 GW 3 hr. 60/3749-64
104/3723-49 168/3723-65 S/2½ BOPH
500 A P/84 BO 7 BW 7 hrs.
Comp. 2866 BOPD 6% wtr.

COMPLETED

