

Sec. 12 Twp. 22 R. 14 W

Well No. # 3 Williams Farm

Shell Oil Company

K & E Drlg. Contractor

N. Oscar Pool


_____ Ft. from N. Line

990 Ft. from S. Line

_____ Ft. from E. Line

990 Ft. from W. Line

NE SW SW

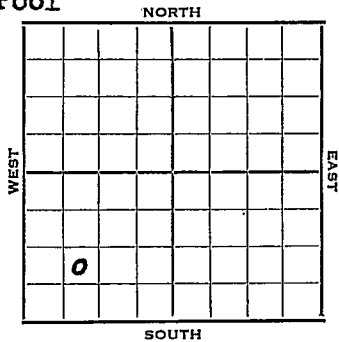

1953 Elev. 1927' REPORT

Arb. Test

- 4/8 RUR
- 4/16 8" @ 802
Drlg 3155'
- 4/23 Lans 3411, V. 3674, Arb 3752
RTD 3754 Schl.
5" @ 3752'
- 4/30 DD 3762 500 A 1 goph 4 Hrs. 1500 A
S/ 100 bo 3 hrs. DD 3767
TD
S/ 99 Bo 3 hrs. 500 A S/ 93 Bo 3 Hrs.
POP.
- 5/7 NR
- 5/13 Spud 4-8-53 Oil well TD 3767
8" @ 802 Lans 3411 Viola 3674'
Arb. 3752 TD 3754 5" @ 3752
DD 3762 500 A 1 GOPH 4 hr. 1500 A
S/100 BO 3 hr. DD 3767 S/99 BO
3 hr. 500 A S/93 BO 3 hr.
Comp. 480 BOPD

COMPLETED

3752
1927
- 1925

