


Section 12 Township 22 Range 11W

Well No. #3 Williams

Company Natural Gas & Oil

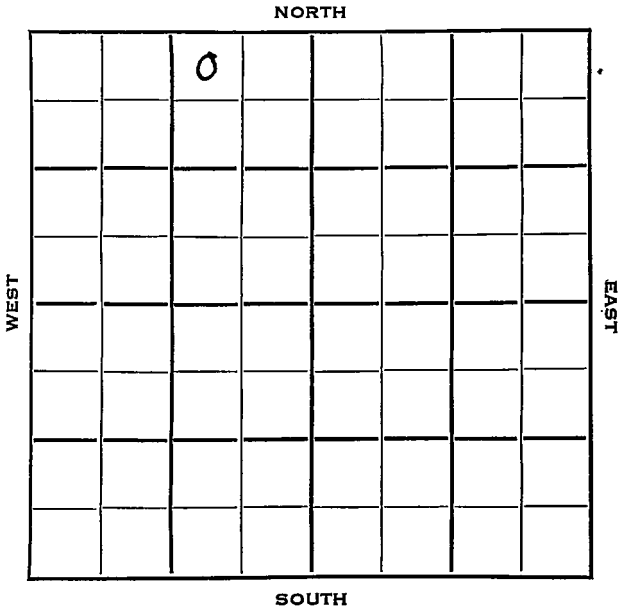

Sec. 12 Twp. 22 R. 14WWell No. #3 Williams Farm

Natural Gas & Oil

Company

Natural Gas & Oil

Contractor

Smallwood Pool


330 Ft. from N. Line

Ft. from S. Line

990 Ft. from E. Line

Ft. from W. Line

NW NE NW

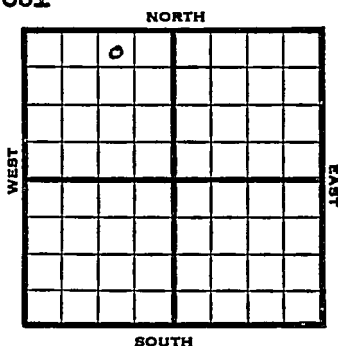

1953 Elev. 1926' REPORT

7/14 Spud 7-10-53

10" @ 335'

Drlg 2155'

7/22 Heeb 3277, Br 1i 3402, Lans 3413
 DST 3415-65, 1 hr., 30' wcm, 1230#
 DST 3572-86, 1 hr., 35' sw, 1320#
 DST 3586-3600, 1 hr., 100' gas, 80'
 v hly O&GCM, 160#,

Drlg. 3610'

7/29 B KC 3631 V 3663 Simp 3687

Arb. 3735

DST 3735-45, 1 hr, 160' gas, 240'
 free oil, 60' MCO 600# RTD 3753

Elec. log. 7" @ 3752

8/5 NR

8/12 "

8/19 Spud 7-10-53

Oil Well

TD 3753'

10" @ 335'

Heeb 3277, Br. Lime 3402, Lans 3413,

DST 3415-65 opn 1 hr, rec 30' wcm
 1230#

DST 3572-86 opn 1 hr, rec 35' sw
 1320#

DST 3586-3600 opn 1 hr, rec 100' gas,
 80' vho & gcm 160# B KC 3631'

OVER

1953

Information brought forward.

8/19

Viola 3663, Simp 3687, Arb 3735,
DST 3735-45 opn 1 hr, rec 160' gas,
240' free oil, 60' mco, 600#

TD 3753'

7" @ 3752'

47/ 3748-52 2-3/4 boph

500 A P/ 9 boph 9 hr.

Comp. 450 bopd.

COMPI ETED

County Stafford State KansasSec. 12 (Blk. Twp.) 22 (Sur. Rge.) 14W Map No.Operator Natural Gas & OilWell No. 3 Farm WilliamsElev. Location NW NE NW

		0					

330 Ft. From N Line NW990 Ft. From E Line QuarterIst. Report JUL 14 1953

Completion

Remarks

Natural Gas - Contr.Spudding Date 7-10-53Drig. Data Smallwood pool10" @ 335 • Drig. 2155

J. G. McGEHEE

County Stafford State Kansas
 Sec. 12 (Blk. 22 (Sur. 14W Map No.
 (Twp.) (Rge.)
 Operator Natural Gas & Oil
 Well No. 3 Farm Williams
 Elev. 1926 Location NW NE NW

	0					

330 Ft. From N Line NW
990 Ft. From E Line Quarter
 1st. Report
 Completion AUG 19 1953
 Remarks Smallwood Pool
Natural Gas - Contr.
 Spudding Date 7-10-53 ✓

Drlg. Data Oil Well TD 3753

10" @ 335 Heeb. 3277 Br. lime 3402

Lans. 3413 DST 3415-65 open 1 hr.

Rec. 30' wcm 1230# DST 3572-86

open 1 hr. Rec. 35' sw 1320#

DST 3586-3600 open 1 hr. Rec. 100' gas

80' vho & gcm 160# B KC 3631

Viola 3663 Simp. 3687 Arb. 3735

DST 3735-45 open 1 hr. Rec. 160' gas

240' free oil 60' mco 600# TD 3753

7" @ 3752 47/ 3748-52 2 3/4 boph

500 A P/ 9 boph 9 hr.

Comp. 450 bopd

J. G. McGEHEE