

Section 12 Township 22 Range 11WWell No. #1 SmithCompany Mid-Western Drlg.

NORTH

			0				

WEST

EAST

SOUTH

Stafford

KANSAS

Sec. 12 Twp. 22 R. 11W

Well No. #1 Smith Farm

Mid-Western Drlg. Company

Wildcat Contractor


330' Ft. from N. Line

 Ft. from S. Line

330' Ft. from E. Line

 Ft. from W. Line

NE NE SW

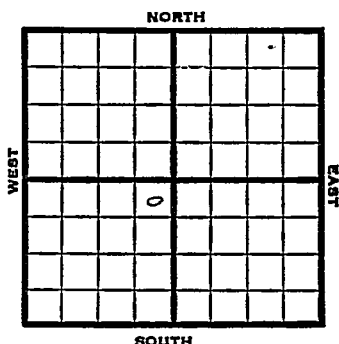


1950 Elev. 1765' REPORT

12/20 RUR

1951
1/10 D&A TD 3622
Heeb. 3009' Br Lime 3142 Lans. 3162
Congl 3470 Viola 3497 Simp. 3518
Arb. 3572 TD 3622 D&A

ABANDONED

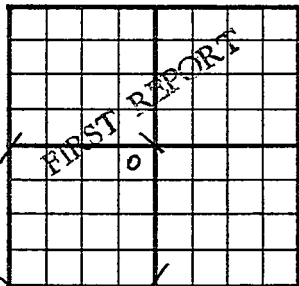County Stafford State KansasSec. 12 (Blk. Twp.) 22 (Sur. Rge.) 11W Map No.Operator Mid-Western Drlg.Well No. 1 Farm SmithElev. Location NE NE SW330 Ft. From N Line SW330 Ft. From E Line Quarter1st. Report DEC 20 1950


Completion

Remarks Phillips & SkellyDHM

Spudding Date

Drlg. Data WildcatR U R

County Stafford State Kansas
 Sec. 12 (Blk. 22 (Sur. 11W Map No.
 (Twp.) (Rge.)
 Operator Mid-Western Drlg.
 Well No. 1 Farm Smith
 Elev. 1765 Location NE NE SW

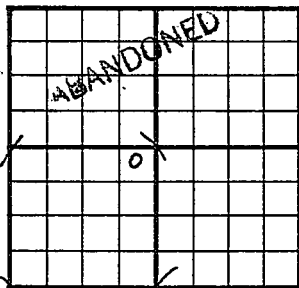

330 Ft. From N Line SW
330 Ft. From E Line Quarter

1st. Report

Completion JAN 10 1959

Remarks Wildcat

Spudding Date

Drlg. Data D & A TD 3622

Heeb. 3009 Br. lime 3142 Lans. 3162

Cong. 3470 Viola 3497 Simp. 3518

Arb. 3572 TD 3622

D & A

J. E. TYRA