


Stafford

Section 12 Township 22 Range 12WWell No. #1 WillingerCompany M. B. Armer

NORTH

WEST

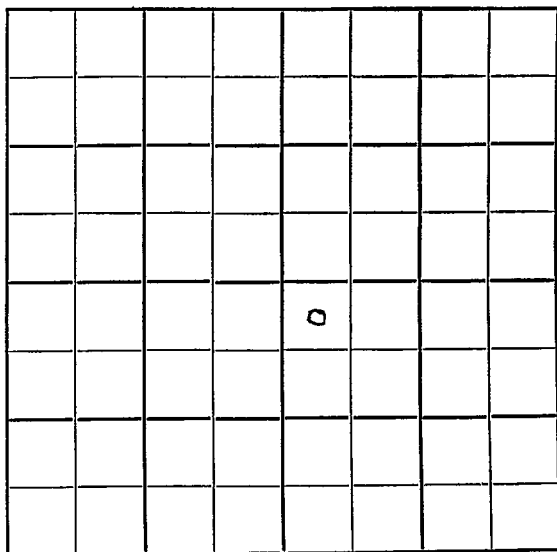

EAST

SOUTH

Stafford

KANSAS

Sec. 12 Twp. 22 R. 12 W ✓

Well No. # 1 Willinger Farm

M. B. Arner Company

Contractor

Max Pool

330 Ft. from N. Line


 Ft. from S. Line

 Ft. from E. Line

330 Ft. from W. Line

NW NW SE

CSO farmout

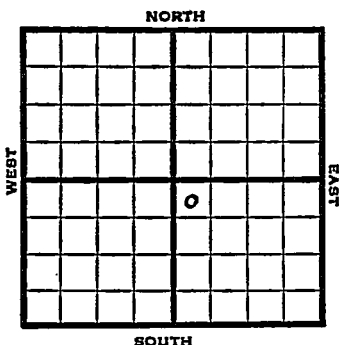

1951

Elev. 1809' REPORT

3/7


Spud 3-3-51
8" @ 261
Anhy 571
Drilling 1700'

5/9

Spud 3-3-51
Oil Well TD 3611
8" @ 261 Anhy 571
Heeb. 3078 Br Lime 3209
Lans. 3235.
DST 3270-3316 opn 45 min.
Rec. 100' wcm
DST 3410-40 opn 45 min.
Rec. 12' mud
Cong. 3507 Viola 3514
DST 3522-52 opn 1 hr
Rec. 25' mud 2' socm
Simp 3551 Arb. 3598
DST 3600-04 opn 45 min
rec. 38' mud 5" @ 3601 TD 3611
500 A S/8 boph Comp. 386 bopd

COMPLETED

County Stafford State Kansas
 Sec. 12 (Blk.) 22 (Sur.) 12W Map No.
 Operator M. B. Armer
 Well No. 1 Farm Willinger
 Elev. 1809 Location NW NW SE

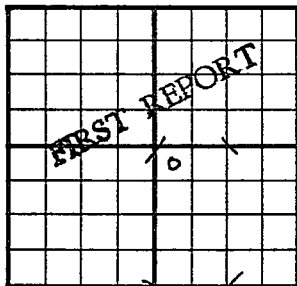

330 Ft. From N Line SE
330 Ft. From W Line Quarter

1st. Report MAR 7 1951

Completion


Remarks CSO farmout

Spudding Date 3-3-51

Drlg. Data Max Pool

8" @ 261 Anhy 571 drlg. 1700

J. E. TYRER

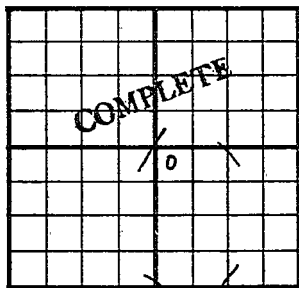County Stafford State KansasSec. 12 (Blk.
Twp.) 22 (Sur.
Rge.) 12W Map No.Operator M. B. ArmerWell No. 1 Farm WillingerElev. 1809 Location NW NW SE330 Ft. From N Line SE330 Ft. From W Line Quarter1st. ReportCompletion MAY 9 1951Remarks Max PoolSpudding Date 3-3-51Drlg. Data Oil well TD 36118" @ 261 Anhy 571 Heeb. 3078Br. lime 3209 Lans. 3235 DST 3270-3316open 45 min. Rec. 100' wcm DST 3410-40open 45 min. Rec. 12' mud Cong. 3508Viola 3514 DST 3522-52 open 1 hr.Rec. 25' mud 2' socm Sirp. 3551Arb. 3598 DST 3600-04 open 45 min.rec. 38' mud 5" @ 3601 TD 3611 500 AS/ 8 boph Comp. 386 bopd.

J. E. TYRA