


Section 12 Township 22 Range 12 W

Well No. # 3 Willinger

Company B & B Drlg.

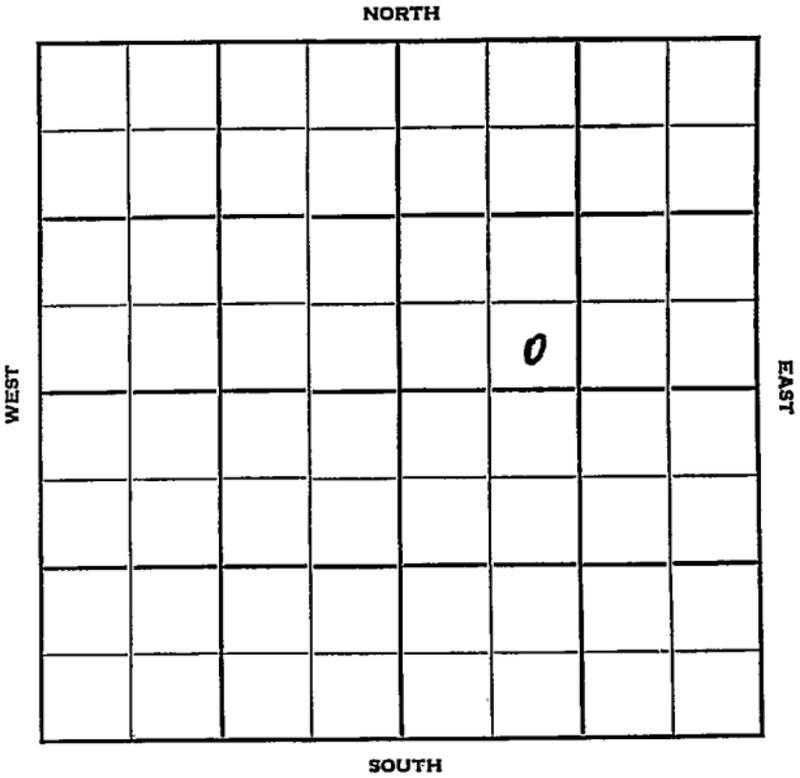

Sec. 12 Twp. 22 R. 12W

Well No. #3 Willinger Farm

B & B Drlg. Company

B & B Drlg. Contractor

Max Pool


_____ Ft. from N. Line

330 _____ Ft. from S. Line

_____ Ft. from E. Line

990 _____ Ft. from W. Line

SE SW NE

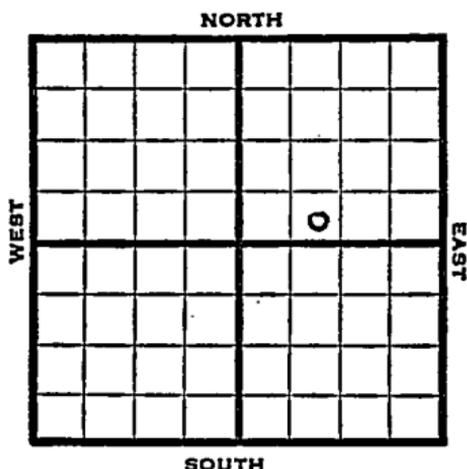

1953 Elev. 1800' REPORT

- 6/17 Spud 6-10-53
8" @ 207'
Anhy 570'
SD @ 2237'
- 6/24 Heeb 3065, Br. L. 3197, Lans 3221, V. 3489
DST 3277-3312, 1 hr, 180' Hly OCM 160#
DST 3352-3410, 3/4 hr, 20' M
DST 3411-41, 1/2 hr, 25' M
DST 3454-81, 25' M 10' M
Simp 3541, Arb 3591
RTD 3594
5" @ 3593'
- 7/1 Steel line Cor 3594-3595 500 A no
Help DD 3598 1000 A no help.
- 7/8 CO 3595' 2250 A S/2 1/2 BOPH.
- 7/22 NR
- 8/12 "
- 8/19 Spud 6-10-53
Oil Well
TD 3595'
8" @ 207'
Anhy 570, Heeb 3065, Br. Lime 3197'

OVER

1953

Information brought forward.

8/19

Lans 3221, Viola 3489

DST 3277-3312 opn 1 hr, rec 180'
hocm 160#

DST 3352-3410 opn 3/4 hr, rec 20' mud

DST 3411-41 opn 1/2 hr, rec 25' mud 0#

DST 3454-81 opn 25 min rec 10' mud 0#

Simp 3541', Arb 3591',

TD 3594'

5" @ 3593'

SIM 3594-3595

GO to 3595 500 A DD 3598 1000 A

GO to 3595 2250 A S/ 2 1/2 boph 8 hr.

Comp. 30 bopd 25% wtr.

COMPLETED

