

Stafford


KANJAS

SECTION 12 TOWNSHIP 22 RANGE 12W

WELL NO. #1 Willinger

COMPANY Cities Service

NORTH

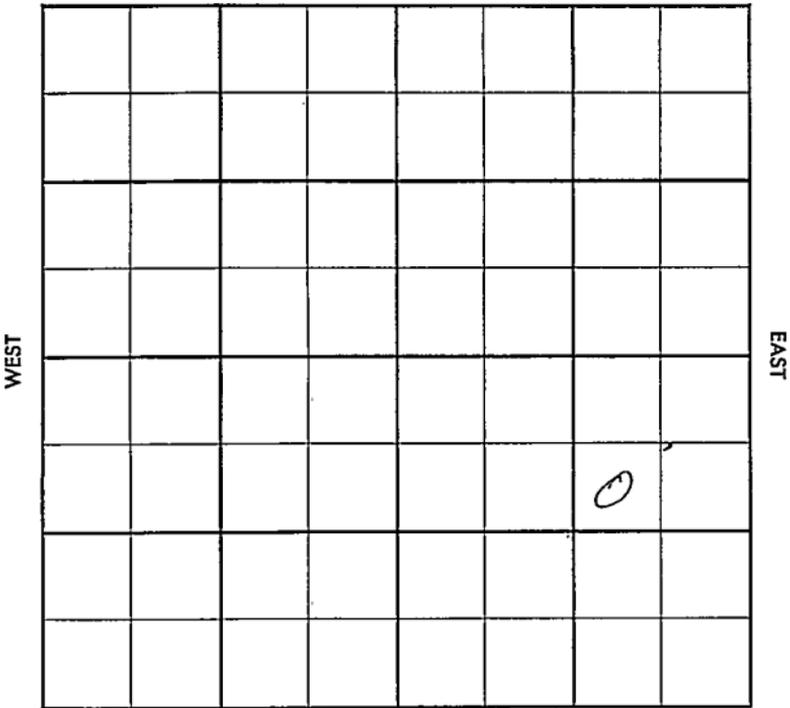

SOUTH

**Stafford KANSAS**


SEC. 12	TWP. 22	R. 12W
------------	------------	-----------

WELL NO. #1 Willinger FARM

COMPANY  
Cities Service

CONTRACTOR  
Prime Drlg.

\_\_\_\_\_ Ft. from N. Line  
 \_\_\_\_\_ Ft. from S. Line  
 \_\_\_\_\_ Ft. from E. Line  
 \_\_\_\_\_ Ft. from W. Line

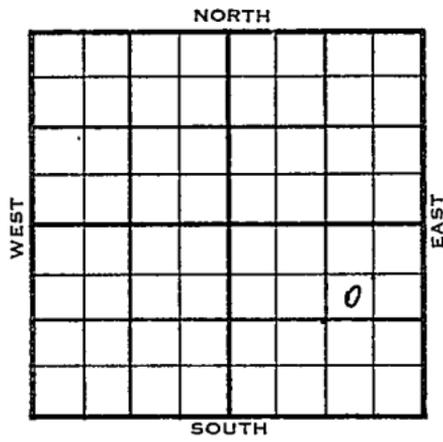

SW NE SE

1956	ELEVATION	REPORT
	1788	

3-28 Comm. 3-26-56  
 8" & 339  
 Drlg. 1935

4-11 DST 3595-3600 op 1 hr. rec. 30' sgcm  
 150/60"  
 D & A  
 H. 3072  
 BL 3202  
 L. 3227  
 V. 3497  
 S. Sh. 3552  
 A. 3594  
 TD 3625

**ABANDONED**

County **Stafford** Elev. \_\_\_\_\_  
 Sec. **12** Twp. **22** Rge. **12W**  
 Company **Cities Service**  
 FarmName **Willinger** No. **1**

TOPS	DEPTH	LOG	DATUM	Loc. in Sec.
Anh.				SW NE SE
Tp.				
H.				
Tr.				
Dg.				
Bl.				
L.				Geol. _____
K.C.				Contr. _____
B.K.C.				<b>Prime Drlg.</b>
Ce.				
C.				Pool
M.				<b>Max</b>
M.				
K.				
Mz.				
Me.				
V.				
S.				
S.				FIRST REPORT
A.				
R.				
Pe.				
G.				
T.D.				

MAR 28 '56

Date Comm. **3-26-56**  
**8" @ 339 drlg. 1935**

*[Large handwritten scribble]*

Co.  
Lse.  
No.  
Sec.  
T.  
R.

County Stafford Elev. 1788  
 Sec. 12 Twp. 28 Rge. 12W  
 Company Cities Service  
 Farm Name Willinger No. 1

TOPS	DEPTH	LOG	DATUM
Anh. #			
Tr.			
H.	<u>3072</u>		
Tr.			
Dg.			
Bl.	<u>3202</u>		<u>1414</u>
L.	<u>3227</u>		<u>1439</u>
K.C.			
B.K.C.			
Ce.			
C.			
M.			
M.			
K.			
Mz.			
Me.			
V.	<u>3497</u>		<u>1709</u>
S. <u>26</u>	<u>3552</u>		<u>1764</u>
S.			
A.	<u>3594</u>		<u>1806</u>
R.			
PE.			
G.			
T.D.	<u>3625</u>		

Loc. in Sec. SW NE SE

Geol. \_\_\_\_\_

Contr. \_\_\_\_\_

Prime Drlg. \_\_\_\_\_

Pool \_\_\_\_\_

Max \_\_\_\_\_



Date Comm. 3-26-56 APR 1 1 1956

8" @ 339 DST 3595-3600 open 1 hr.

rec. 30' sgcm 150/60"

D & A

Co.  
No.  
Sec.  
T.  
R.