

DX 78-1


Stafford

KANSAS

Section 12 Township 22 Range 12W

Well No. #1 Willinger

Company Stearns Pet.

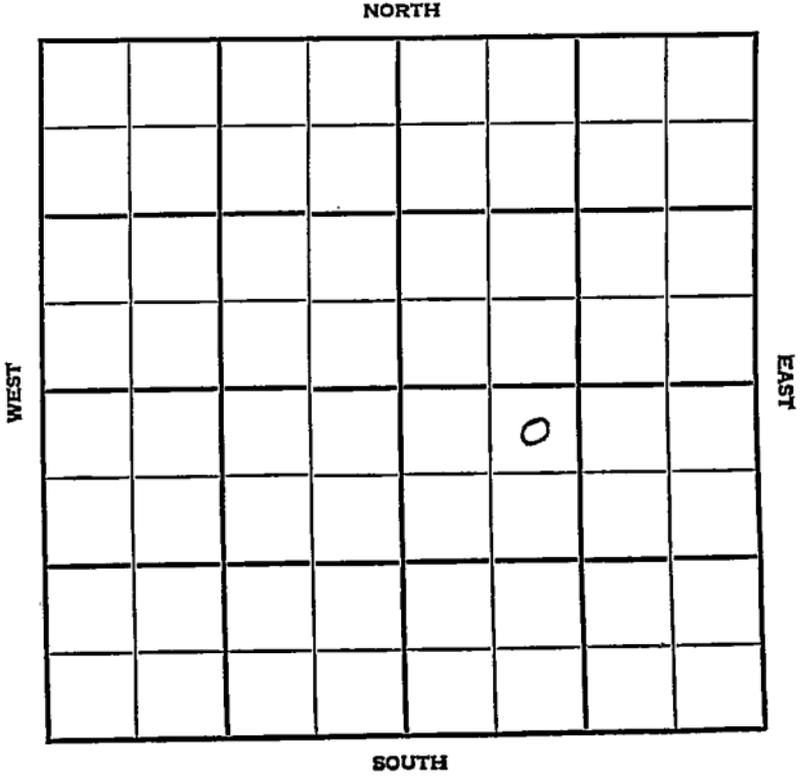

Stafford

KANSAS


SEC. 12	TWP. 22	R. 12W
------------	------------	-----------

WELL NO. **1 Willinger** FARM

COMPANY **Stearns Pet.**

CONTRACTOR **Co. Tools
Max Pool**

330' _____ Ft. from N. Line
 _____ Ft. from S. Line
 _____ Ft. from E. Line
990' _____ Ft. from W. Line

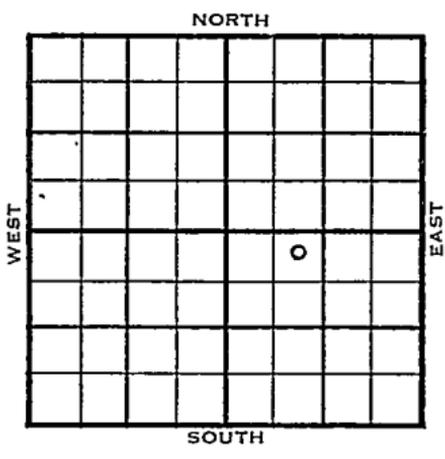

NE NW SE

1955	ELEVATION 1797	REPORT
------	-------------------	--------

6/1 Spud 5-29-55
 8" @ 208 w/175
 Anhy 552, Drlg 576

7/20 Comm 5-29-55
 H 3062
 KC 3216
 V 3486
 S 3510
 A 3508
 TD 3572
 8" @ 208/175 DST 3276/3400 open
 1 hr. Rec 35' ocm 430/30" DST 3568-
 72 open 15 min. Rec 305' oil 770/20"
 5 1/2" @ 3569 CO to 3572
 S/119 bo 12 hr S/5,87 boph P/25 bopd
 Comp 45 BOPD

COMPLETED

County Stafford Elev. 1797
 Sec. 12 Twp. 22 Rge. 12W
 Company Stearns Pet.
 Farm Name Willinger No. 1

TOPS	DEPTH	LOG	DATUM
Anh.			
TP.			
H.	<u>3062</u>		<u>1265</u>
Tr.			
Dg.			
Bl.			
L.			
K.C.	<u>3216</u>		<u>1419</u>
B.K.C.			
Ce.			
C.			
M.			
M.			
K.			
Mz.			
Me.			
V.	<u>3486</u>		<u>1689</u>
S.	<u>3510</u>		<u>1713</u>
S.			
A.	<u>3568</u>		<u>1771</u>
R.			
PE.			
G.			
T.D.	<u>3572</u>		

Loc. in Sec. NE NW SE

Geol. _____

Contr. _____

Co. tools _____

Pool _____

Max _____

COMPLETE

Date Comm. 5-29-55 JUL 20 1955

8" @ 208/175 DST 3276-3400 open 1 hr.

Rec. 35' ocm 430/30" DST 3568-72

open 15 min Rec. 305' oil 770/20"

5 1/2" @ 3569 CO to 3572 S/119 bo 12 hr.

S/ 5.87 boph P/ 25 bopd

Comp. 45 bopd

Co. No. Sec. T. R.