


Section 12 Township 22 Range 12W

Well No. #1 Willinger

Company B & B Drlg.

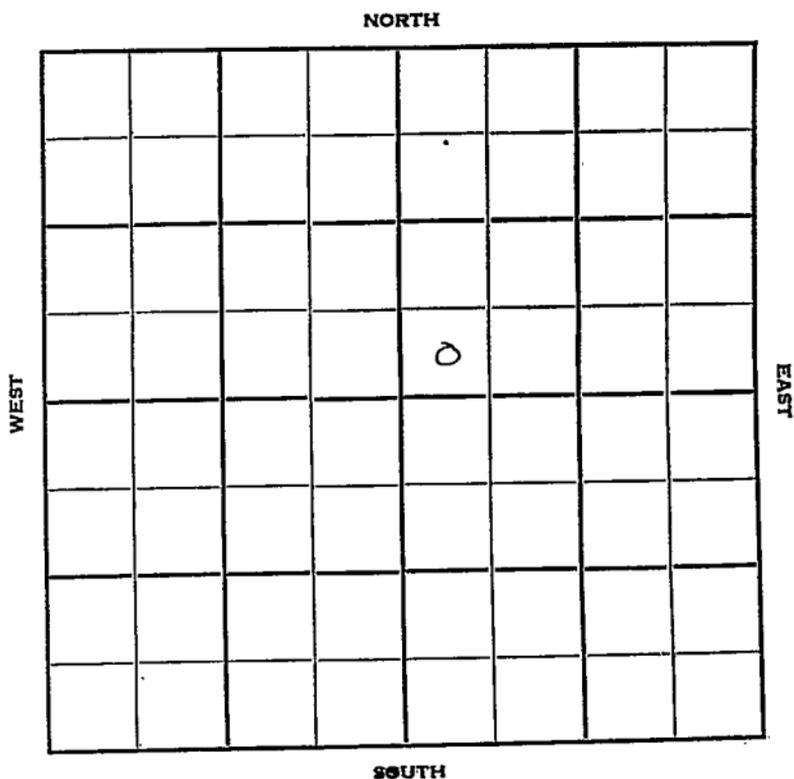

Sec. 12 Twp. 22 R. 12W ✓

Well No. #1 Willinger Farm

B & B Drlg. Company

Contractor

Max Pool


Ft. from N. Line

330' Ft. from S. Line

Ft. from E. Line

330' Ft. from W. Line

SW SW NE

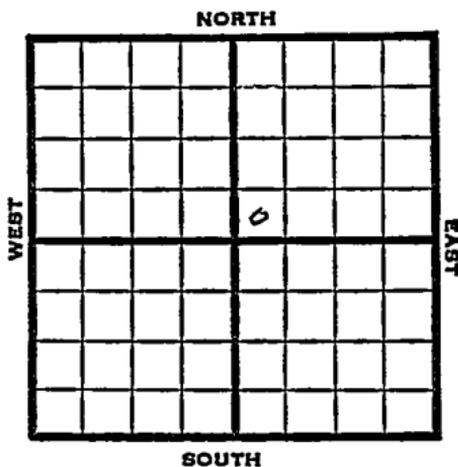

1951

Elev. 1812' REPORT

4/25

Location

6/13

Spud 4-25-51  
Oil Well TD 3590  
8" @ 224 Anhy 830-50  
Br Lime 3214 Lans. 3239  
Cong. 3498 Viola 3505  
Simp. 3532 Arb. 3582  
5" @ 3588 TD 3590  
Comp. 402 bopd

**COMPLETED**

County **Stafford** State **Kansas**

Sec. **12** (Blk. Twp.) **22** (Sur. Rge.) **12W** Map No.

Operator **B & B Drlg.**

Well No. **1** Farm **Willinger**

Elev. Location **SW SW NE**

<b>FIRST REPORT</b>		0	

**330** Ft. From **S** Line **NE**

**330** Ft. From **W** Line Quarter

1st. Report **APR 25, 1951**

Completion

Remarks

Spudding Date

Drlg. Data **Max Pool**

**Location**

**J. E. TYRA**


County Stafford State Kansas

Sec. 12 (Blk. Twp.) 22 (Sur. Rge.) 12W Map No.

Operator B & B Drlg.

Well No. 1 Farm Willinger

Elev. 1812 Location SW SW NE

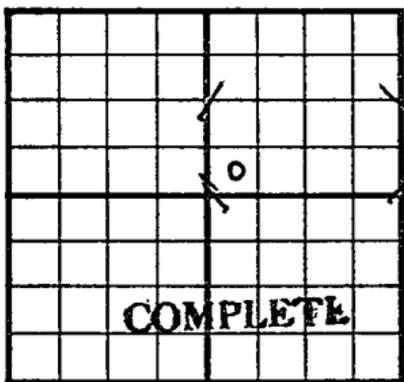

330 Ft. From S Line NE

330 Ft. From W Line Quarter

1st. Report

Completion JUN 13 1951

Remarks Max Pool

Spudding Date 4-25-51

Drlg. Data Oil well TD 3590

8" @ 224 Anhy 830-50 Br. lime

3214 Lans. 3239 Cong. 3498

Viola 3505 Simp. 3532 Arb. 3582

5" @ 3588 TD 3590 Comp. 402 bopd

J. E. TYRA