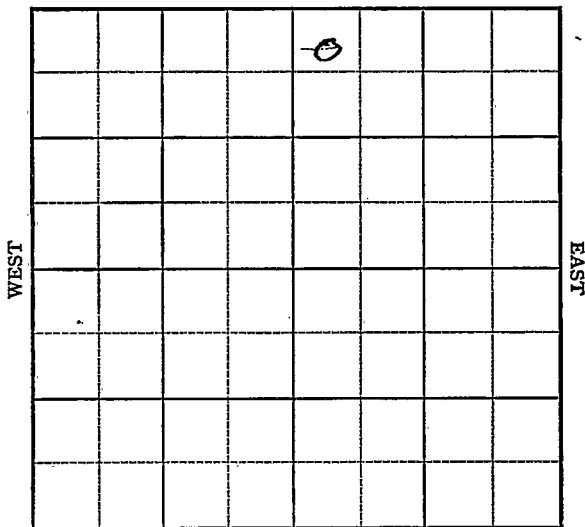


KANSAS

Stafford

Section 12 Township 22 Range 12WWell No. 1 WillingerCompany Lindas et alMax
NORTH

KANSAS

Stafford

Sec. 12 Twp. 22 R. 12W ✓

Well No. #1 Willinger Farm

Lindas et al Company

Max Pool


330' Ft. from N. Line

_____ Ft. from S. Line

_____ Ft. from E. Line

330' Ft. from W. Line

NW NE

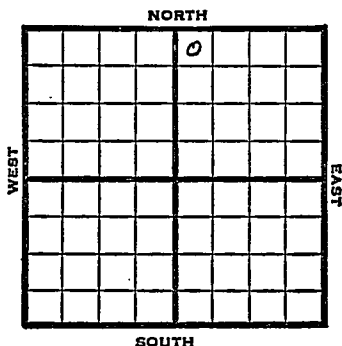

1949

Elev 1815'

REPORT

3/30

8" @ 254'

Anhy 580'

Drlg. 1200'

54/6

TD 3633' in Cong

Lans. 3256'

Cong 3561'

Aband.

ABANDONED

Map No. _____ Sec. 12 Twp. 22 R. 12W

Well No. 1 Willinger

Lindas etal. Company

FIRST REPORT Contractor

NW NE


SECTION PLAT

330 Ft. from N. Line

_____ Ft. from S. Line

_____ Ft. from E. Line

330 Ft. from W. Line

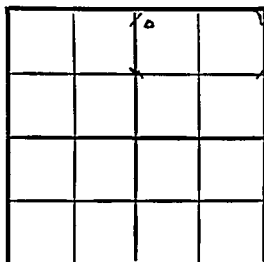

Stafford County

RECORD

Location _____

Cased _____ in., _____ ft.

Rig up _____

Sand _____

Drilling and Remarks:

Gas _____

8" @ 254

Oil _____

Anhy 580

Total Depth _____

drlg. 1200

PRODUCTION

1st 24 hrs. Nat. _____

1st 24 hrs. after shot _____

Gas _____ Cu. Ft.

Dry Hole _____

Abandoned _____

Date

MAR 30 1949 19

S. J. LEWIS


Scout

Kansas

Map No. 46 Sec. 12 Twp. 22 R. 12WWell No. 1 WillingerLindas etal. Company**ABANDONED**

Contractor

NW NE

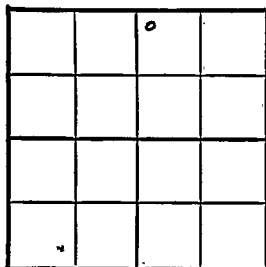E11815
SECTION FLAT330 Ft. from N. Line Ft. from S. Line Ft. from E. Line330 Ft. from W. LineStafford CountyLocation Rig up

Drilling and Remarks:

Home 3256
*Conq 3561***RECORD**Cased in., ft.Sand Gas Oil Total Depth 3633 in Conq**PRODUCTION**1st 24 hrs. Nat. 1st 24 hrs. after shot Gas Cu. Ft.Dry Hole Abandoned

Date

APR 6 1949 19S. J. LEWIS Scout