

KANSAS

Stafford

Section 12 Township 22 Range 12N

Well No. 1 Wokaty

Company Shawver-Graham

Reserve Drig.- Contrac.

NORTH

Max Pool

			0				

WEST

EAST

SOUTH

Sec. 12 Twp. 22 R. 12W

Well No. #1 Wokaty Farm

Shawver - Graham Company

Max Pool (Reserve Drlg., Cont.)


330' Ft. from N. Line

_____ Ft. from S. Line

330' Ft. from E. Line

_____ Ft. from W. Line

NE NW

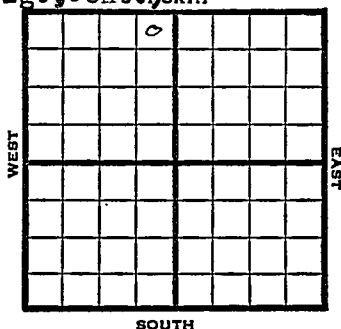

Elev. 1878' REPORT

1949

- 6/1 8" @ 230'
Drlg. 1665'
- 6/7 Lansing 3244'
Viola 3520'
Simpson 3532'
Arb. 3570' - 82'
TD 3572'
5" @ 3570 1/2
- 6/15 "
- 6/21 TD 3574'
Swb 40 bbls oil a day
- 6/28 "
- 7/6 "
- 7/12 1500 acid
- 7/20 Complete
Arb. 3570'
7" @ 3570 1/2
1500 acid
Pump 40 oil Pot
Grav 40
TD 3574'

COMPLETED

Map No. _____ Sec. 12 Twp. 22 R. 12W

Well No. 1 Wokaty

Shawver - Graham Company

Reserve Drlg. Contractor

NE NW

FIRST REPORT
SECTION PLAT

330 Ft. from N. Line

_____ Ft. from S. Line

330 Ft. from E. Line

_____ Ft. from W. Line

Stafford County

Location _____

Rig up _____

Drilling and Remarks:

8" @ 230

drlg. 1665

RECORD

Cased _____ in., _____ ft.

Sand _____

Gas _____

Oil _____

Total Depth _____

PRODUCTION

1st 24 hrs. Nat. _____

1st 24 hrs. after shot _____

Gas _____ Cu. Ft.

Dry Hole _____

Abandoned _____

Date

JUN 1 1949 19

S. J. LEWIS Scout

Kansas

Max Pool

Map No. K46 Sec. 12 Twp. 22 R. 12WWell No. 1 Wokaty

Shawver - Graham

Company

COMPLETE

Contractor

NE NW

E. J. LEWIS
SECTION PLAT330 Ft. from N. Line Ft. from S. Line330 Ft. from E. Line Ft. from W. Line

	6		

Stafford County

Location _____

Rig up _____

Drilling and Remarks:

*Case 3570**5" @ 3570 1/2**1500 acid**Pump 40 oil P&S**40° E*

RECORD

Cased _____ in., _____ ft.

Sand _____

Gas _____

Oil _____

Total Depth 2574

PRODUCTION

1st 24 hrs. Nat _____

1st 24 hrs. after shot _____

Gas _____ Cu. Ft.

Dry Hole _____

Abandoned _____

Date

JUL 20 1949

19

S. J. LEWIS

Scout