


Section 12 Township 22 Range 12W

Well No. #2 Wokaty

Company Stanolind

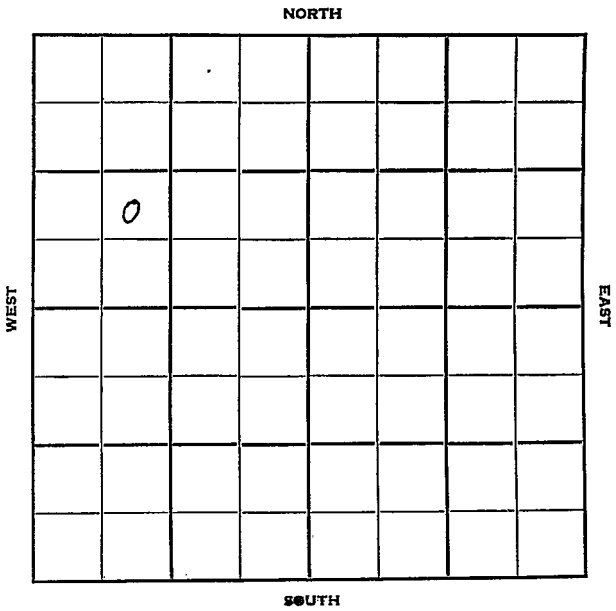

Stafford

KANSAS

Sec. 12 Twp. 22 R. 12W

Well No. #2 Wokaty Farm

Stanolind

Company

Max Pool

Contractor


 Ft. from N. Line

990' Ft. from S. Line

 Ft. from E. Line

990' Ft. from W. Line

NE SW NW

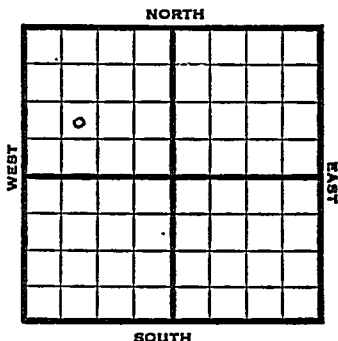

1951

Elev. 1828' REPORT

5/23

Location

8/15

Spud 7-2-51

Oil Well TD 3591

Anhy 497

8" @ 605

Lans. 3249

Arb. 3582

DST 3582-87 opn 1 hr

Rec. 240' oil 5" @ 3582

GO to 3587 TD

FU 1600' oil

S/4 boph 500 A

S/6 $\frac{1}{2}$ boph 2000 A

S/11 Boph 2000 A

S/14 boph DD 3591

S/15 boph S/20 boph 4 hr.

1000 A S/24 $\frac{1}{2}$ boph 4 h .

Comp. 3000 bopd

COMPLETED

County Stafford State Kansas
 Sec. 12 (Blk. 22) (Sur. 12W) Map No. _____
 Operator Stanolind
 Well No. 2 Farm Wokaty
 Elev. _____ Location NE SW NW

FIRST REPORT

990 Ft. From S Line NW
990 Ft. From W Line Quarter
 1st. Report MAY 23 1951
 Completion _____
 Remarks _____
 Spudding Date _____

Drlg. Data. Max Pool

Location

J. E. TYRA

County Stafford State Kansas
 Sec. 12 (Blk.) 22 (Sur.) 12W Map No.

Operator Stanolind

Well No. 2 Farm Wekaty

Elev. 1828 Location NE SW NW

COMPLETE

990 Ft. From S Line NW

990 Ft. From W Line Quarter

1st. Report

Completion AUG 15 1951

Remarks Max Pool

Spudding Date 7-2-51

Drlg. Data Oil well TD 3591

Anhy 497 8" @ 605 Lans. 3249

Arb. 3582 DST 3582-87 open 1 hr.

Rec. 240' oil 5" @ 3582 CO to 3587 TD

FU 1600' oil S/ 4 boph 500 A S/ $6\frac{1}{2}$ boph

2000 A S/ 11 boph 2000 A S/ 14 boph

DD 3591 S/ 15 boph S/ 20 boph 4 hr.

1000 A S/ $24\frac{1}{2}$ boph 4 hr.

Comp. 3000 boph

J. E. TYRA