

Stafford

KANSAS

Section 12 Township 22 Range 12 W

Well No. # 2 Voight

Company Northern Ordnance et al

NORTH

WEST

EAST

0

SOUTH

Stafford **KANSAS**

Sec. 12 Twp. 22 R. 12W ✓

Well No. #2 Voight Farm

Northern Ordnance et al Company

Hilton - Contr. Contractor


Max Pool
330' Ft. from N. Line

 Ft. from S. Line

330' Ft. from E. Line

 Ft. from W. Line

NE NE SW

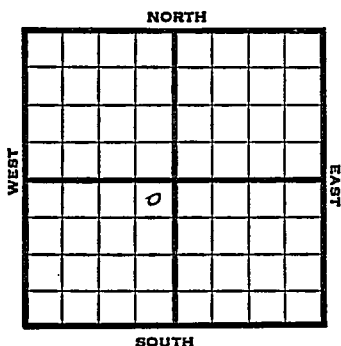


1951	Elev. 1821	REPORT
6/27	Spud 6-26-51.	
9/12	6-26-51 Oil Well TD 3665 8" @ 215 Anhy 585 Heeb. 3092 Br Lime 3222 Lans. 3246 DST 3416-52 opn 45 min. Rec. 30' so & gcm Cong. 3510 Viola 3520 Simp 3551 Sand 3610-19 Arb. 3619-65 5" @ 3617 CO to 3643 12/3615-17 500 A S/11 boph Comp. 149 bopd 34% wtr.	
	COMPLETED	

County Stafford State Kansas
 Sec. 12 (Blk. 22 (Sur. 12W Map No.

Operator Northern Ordnance - etal.

Well No. 2 Farm Voight

Elev. Location NE NE SW

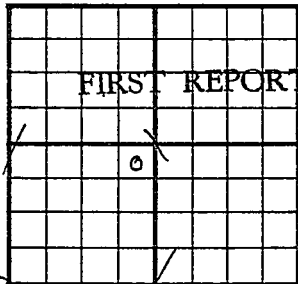

330 Ft. From N Line SW

330 Ft. From E Line Quarter

1st. Report JUN 27 1951

Completion

Remarks

Hilton - Contr.


Spudding Date 6-26-51

Drlg. Data

Max - pool

J. E. TYRA

County Stafford State Kansas
 Sec. 12 (Blk. 22) (Sur. 12W) Map No. _____
 Operator Northern Ordnance etal.
 Well No. 2 Farm Voight
 Elev. 1821 Location NE NE SW

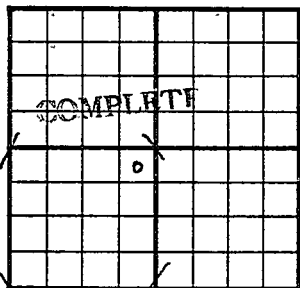

330 Ft. From N Line SW

330 Ft. From E Line Quarter

1st. Report

Completion SEP 12 1951

Remarks Max Pool

Hilton - Contr.

Spudding Date 6-26-51

Drig. Data Oil well TD 3665

8" @ 215 Anhy 585 Heeb. 3092

Br. lime 3222 Lans. 3246 DST 3416-52

open 45 min. Rec. 30' so & gcm Cong. 3510

Viola 3520 Simp. 3551 sand 3610-19

Arb. 3619-65 5" @ 3617 CO to 3643

12/ 3615-17 500 A S/ 11 boph

Comp. 149 bopd 34% water

J. E. TYRA