
FORM 51 25M 8-50 WESTERN

Kearny KANSAS

Section 12 Township 22 Range 36 W

Well No. # 1 Steenis

Company Warren Petroleum

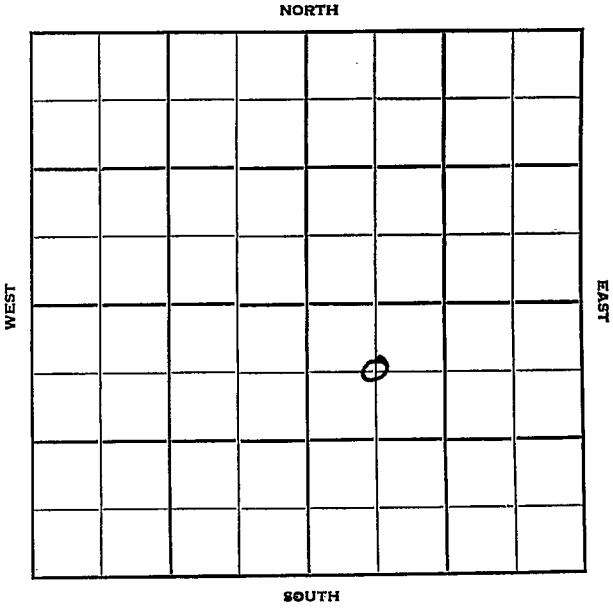

FORM 252-B
10M 8-51 TPCO. Kearny KANSAS

Sec. 12 Twp. 22 R. 36W

Well No. #1 Steenis Farm

Warren Petroleum Company

Contractor


660 Ft. from N. Line

Ft. from S. Line

Ft. from E. Line

660 Ft. from W. Line

C NW SE

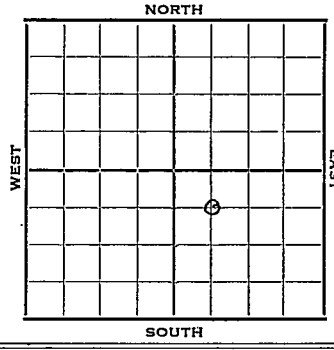

1952	Elev. 3192 REPORT
6/11	**Location**
6/18	10" @ 225' RTD @640' 7" @ 2630' RUST
6/25	NR
7/2	NR
7/9	TD 2860' PB 2705 140 qts. 18,000 A Her 2666' Krider 2685' Winfield 2720 Up Ft. 2792' Low Ft 2826-58'
7/16	Spud 6-6-52 Gas Well TD 2860 10" @ 225 7"@ 2630 TD 2860 PB 2705 140 qt 18,000 A Her. 2666-85 Kri 2685 Win. 2720 Ft. Riley 2792 Comp. 1,200,000 gas 400# COMPLETED

FORM 275 FOR SALE BY KANSAS BLUE PRINT CO


County Kearny State KANSAS

Sec. 12 (Blk. / Twp.) 22 (Sur. / Rge.) 36W Map No.

Operator Warren Petroleum

Well No. 1 Farm Steenis

Elev. Location C NW SE

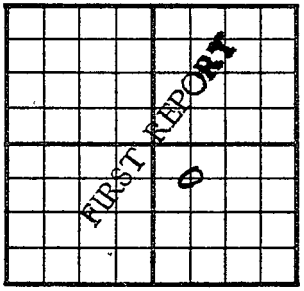

660 Ft. From N Line SE

660 Ft. From W Line Quarter

1st. Report JUN 11 1952

Completion

Remarks

Spudding Date

Drlg. Data

Location

J. G. McGEHEE

FORM 275 FOR SALE BY KANSAS BLUE PRINT CO.


County Kearny State Kansas

Sec. 12 (Blk. / Twp.) 22 (Sur. / Rge.) 36W Map No.

Operator Warren Petroleum

Well No. 1 Farm Steenis

Elev. 3192 Location C NW SE

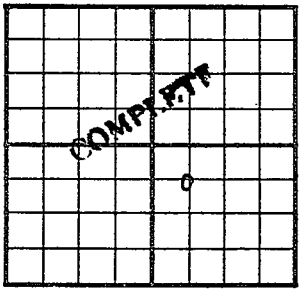

660 Ft. From N Line SE

660 Ft. From W Line Quarter

1st. Report

Completion JUL 16 1952

Remarks

Spudding Date 6-6-52

Drlg. Data Gas well TD 2860

10" @ 225 7" @ 2630 TD 2860

PB 2705 140 qt 18000 A

Her. 2666-85 Kri. 2685 Win. 2720

Ft. Riley 2792 Comp. 1,200,000 gas 400#

J. G. McCUE