


Section 13 Township 22 Range 13-W

Well No. 1 Harms

Company Stanolind

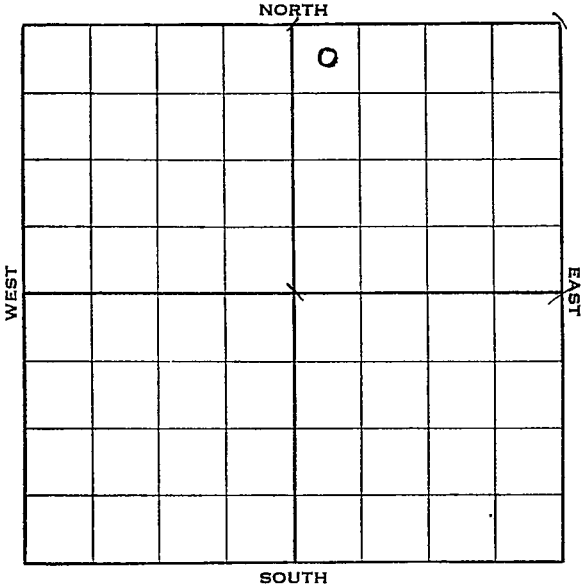

Sec. 13 Twp. 22 R. 13-W

Well No. #1 Harms Farm _____
Stanolina Company _____


330 Ft. from N. Line

_____ Ft. from S. Line

_____ Ft. from E. Line

330 Ft. from W. Line

Elev. 1889'

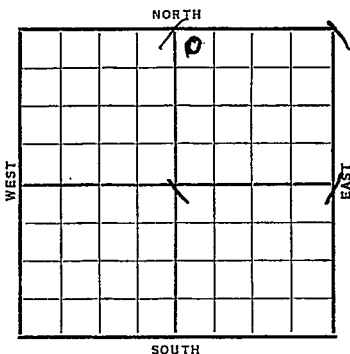

Date	REPORT
1938	
2/2	B. R. R.
2/11	10" @ 249'.
2/18	Anhy 728'. Drlg. 3135'.
2/26	Lans. 3335'. Arb. 3673-75'
	S. O. 6" @ 3673'. RUST.
3/4	Drilled plug. 1700' oil in
	9 hrs. T.D. 3682'.
	Swab 40 oil per hour.
	2000 acid. Swab 72 oil per hr.
	2500' off bottom in 2 hrs.
3/9	6" @ 3673'.
	Arb. 3673'.
	T.D. 3682'.
	2000 acid.
	Potential 1985 bbls.
	COMPLETED

Map No. 82 Sec. 13 Twp. 22 R. 13WWell No. 1 HarmsStanolind Company

Contractor

FIRST REPORT

NW NE

330 Ft. from N. Line

_____ Ft. from S. Line

_____ Ft. from E. Line

330 Ft. from W. Line

SECTION PLAT

		0	

Location _____

Rig up _____

Drilling and Remarks:

BRR

RECORD

Cased _____ in., _____ ft.

Sand _____

Gas _____

Oil _____

Total Depth _____

PRODUCTION

1st 24 hrs. Nat. _____

1st 24 hrs. after shot _____

Gas _____ Cu. Ft.

Dry Hole _____

Abandoned _____

Date

FEB 2 1938H. D. Hatfield Scout

Stafford **KANSAS**Map No. 82 Sec. 13 Twp. 22 R. 13WWell No. 1 HarmsStanolind

Company

Contractor

COMPLETED

NW NE

330 Ft. from N. Line

Ft. from S. Line

Ft. from E. Line

330 Ft. from W. Line**SECTION PLAT**

		0	

Location _____

Rig up _____

Drilling and Remarks:

Iron acid
POT 1985

RECORDCased 6 in., 3673 ft.~~Sand~~ 4-6 3673

Gas _____

Oil _____

Total Depth 3682**PRODUCTION**

1st 24 hrs. Nat. _____

1st 24 hrs. after shot _____

Gas _____ Cu. Ft.

Dry Hole _____

Abandoned _____

Date

MAR 9 - 1938

19

H. D. Hatfield Scout