


KANSAS

Stafford

Section 13 Township 22 Range 13-W

Well No. 2 Louis Harms

Company Stanolind

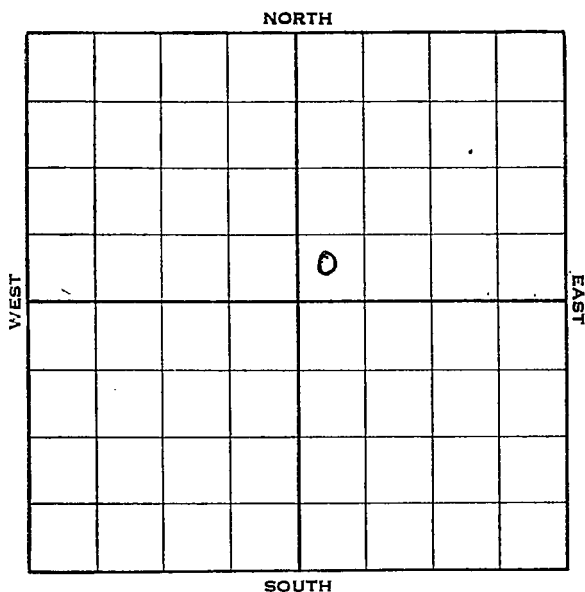

KANSAS

Stafford

Sec. 13 Twp. 22 R. 13-WWell No. #2 Louis Harms FarmStanolind Company


Ft. from N. Line

330 Ft. from S. Line

Ft. from E. Line

330 Ft. from W. Line

Elev. 1888

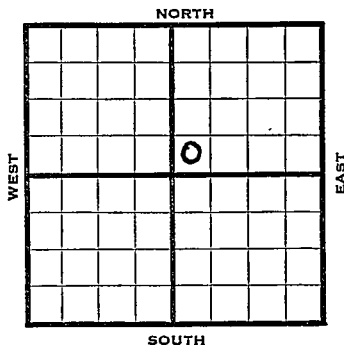

1938	REPORT
5/4	Location
5/12	R U R
5/20	10" @ 270'. Drl g. 2415'.
5/27	Lans. 3355'.
	Spotted Sat. 3470-83'.
	Drl g. 3575'.
6/3	Arb. 3671'. 6" @ 3672'.
	T.D. 3681'. 1100' oil.
6/10	At 3688'. Swab 3½ oil per hr.
	1100 acid. Swab 8 oil per hour.
	T.D. 3697'. 3000 acid.
	Swab 25 oil per hour.
6/15	6" @ 3672'.
	Arb. 3671'.
	T.D. 3701'.
	4100 acid..
	P.B. 3699'.
	Potential 607 oil & 3 water.
	COMPLETED

Stafford KANSAS

Map No. 82 Sec. 13 Twp. 22 R. 13WWell No. 2 Louis HarmsStanolind

Company

Contractor

FIRST REPORT

SW NE

Ft. from N. Line

330 Ft. from S. Line

Ft. from E. Line

330 Ft. from W. Line**SECTION PLAT**

		0	

Location X

Rig up

Drilling and Remarks:

RECORD

Cased _____ in., _____ ft.

Sand _____

Gas _____

Oil _____

Total Depth _____

PRODUCTION

1st 24 hrs. Nat. _____

1st 24 hrs. after shot _____

Gas _____ Cu. Ft.

Dry Hole _____

Abandoned _____

Date

MAY 4 - 1938 19H. D. Hatfield

Scout

Stafford KANSAS

Map No. 82 Sec. 13 Twp. 22 R. 13WWell No. 2 Louis HarmsStanolind

Company

Contractor

COMPLETED

SECTION PLAT

SW NE

Ft. from N. Line

330 Ft. from S. Line

Ft. from E. Line

330 Ft. from W. Line

		0	

Location

Rig up

Drilling and Remarks:

400 Acid

P.B. 3699

POT 607 air
3 wtr

RECORD

Cased 6 in., 3672 ft.Sand Arb 3671

Gas

Oil

Total Depth 3701

PRODUCTION

1st 24 hrs. Nat.

1st 24 hrs. after shot

Gas Cu. Ft.

Dry Hole

Abandoned

Date

JUN 15 1938 19

H. D. Hatfield Scout