

KANSAS


FORM 51 5M 4-41 PETROL

Stafford

Section 13 Township 22 Range 13-W

Well No. #4 Schartz

Company Stanolind

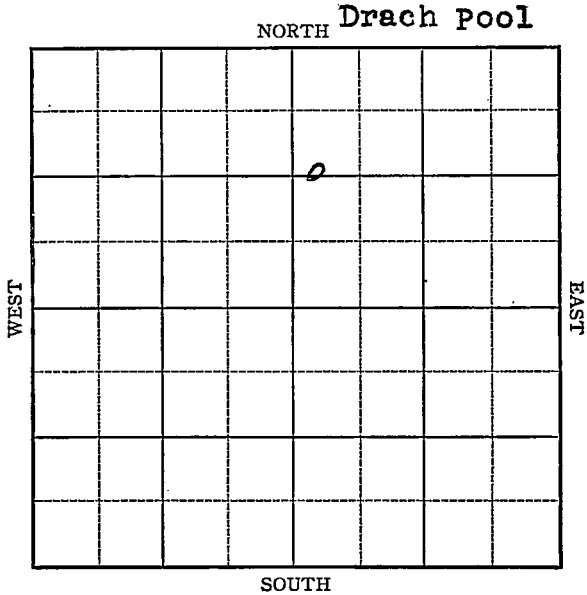

Map No. 82 Sec. 13 Twp. 22 R. 13W

Well No. 4 Schartz

Stanolind Company

Contractor

FIRST REPORT

SECTION PLAT

C W L W $\frac{1}{2}$ NE

		o	

1320 Ft. from N. Line

_____ Ft. from S. Line

_____ Ft. from E. Line

330 Ft. from W. Line

DRACH POOL

Location X

RECORD

Rig up _____

Drilling and Remarks:

Cased _____ in., _____ ft.

Sand _____

Gas _____

Oil _____

Total Depth _____

PRODUCTION

1st 24 hrs. Nat. _____

1st 24 hrs. after shot _____

Gas _____ Cu. Ft.

Dry Hole _____

Abandoned _____


Date

APR 30 1941 19

S. J. LEWIS Scout

Map No. 82 Sec. 13 Twp. 22 R. 13WWell No. 4 Scharztz
Stanolind CompanyCOMPLETE ContractorC W L $W\frac{1}{2}$ NE1320 Ft. from N. Line Ft. from S. Line Ft. from E. Line330 Ft. from W. Line

SECTION PLAT

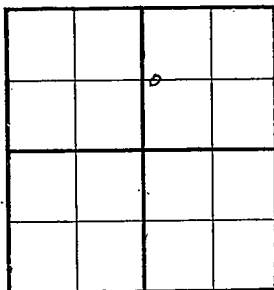

DRACH POOL

Location _____

Rig up _____

Drilling and Remarks:

*CR 83705**5" 83705**PS 3708**130 acid**Pump 101 oil +
66% Water P & Y
363 YW*

RECORD

Cased _____ in., _____ ft.

Sand _____

Gas _____

Oil _____

Total Depth 3710

PRODUCTION

1st 24 hrs. Nat. _____

1st 24 hrs. after shot _____

Gas _____ Cu. Ft.

Dry Hole _____

Abandoned _____

Date

JUN 1 1 1941 19S. J. LEWIS Scout