
Stafford KANSAS

Form 51-5M 5-37 Petrol

Section 13 Township 22 Range 13-W

Well No. #1 Mettscher

Company Stanolind

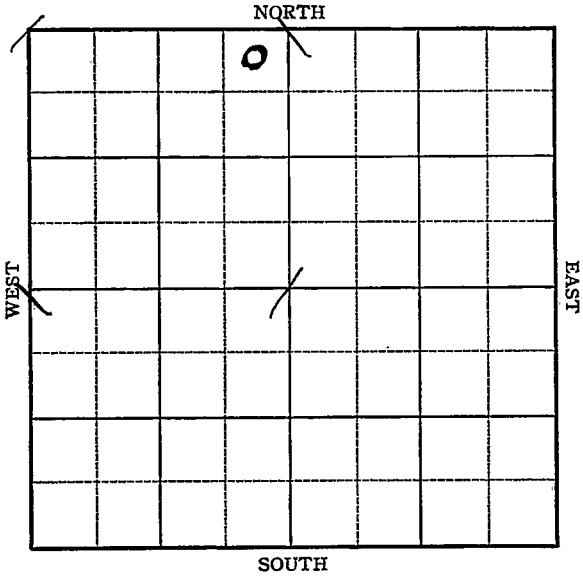

Form 252-A—5M—9-37 KANSAS Stafford

Sec. 13 Twp. 22 R. 13-W

Well No. #1 Mettscher Farm

Stanolind Company


330 Ft. from N. Line

Ft. from S. Line

330 Ft. from E. Line

Ft. from W. Line

Elev. 1889

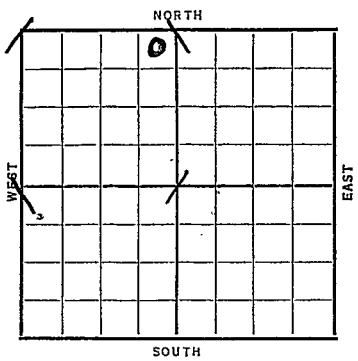

Date	REPORT
1937	
12/15	R. R.
12/24	"
12/31	10" @ 252'. Anhy 734'?
	Drlg. 2100'.
1938	
1/7	K.C. 3335'. Cored 3450-65'.
	No shows. Reaming.
1/10	Viola 3608 Simpson 3630
	Arbuckle 3671 Cored 3675-78
	Recovered 2 feet good saturation
	T.D. 3678 Running 7" casing (Tel)
1/14	T.D. 3678'. 6" @ 3669'. RUST.
1/20	T.D. 3680' 3400' oil Fsg.
1/28	T.D. 3864' Swb 33 oil P.H.
	2 Hrs. 1000' off bottom
	2000 acid.
	OVER

1938

2/2 6" @ 3669'.

Arb. 3671'.

T.D. 3684'.

2000 acid.

Pump 178 bbls. 4 hours and

189 bbls. 4 hours.

Potential 1071 bbls.

COMPLETED

Form 26—1M Bks.—2-29

Stafford KANSAS

Map No. 82 Sec. 13 Twp. 22 R. 13W

Well No. 1 Mettscher

Stanolind Company

Contractor

FIRST REPORT

NE NW


330 Ft. from N. Line

Ft. from S. Line

330 Ft. from E. Line

Ft. from W. Line

SECTION PLAT

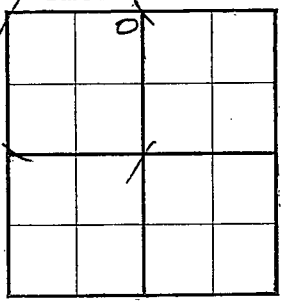

Location

Rig up

Drilling and Remarks:

RR

RECORD

Cased in., ft.

Sand

Gas

Oil

Total Depth

PRODUCTION

1st 24 hrs. Nat.

1st 24 hrs. after shot

Gas Cu. Ft.

Dry Hole

Abandoned

Date

DEC 15 1937 19 H. D. Hatfield Scout

Form 26—1M Bks.—2-29

Stafford KANSAS

Map No. Sec. 13 Twp. 22 R. 13W

Well No. 1 Mettscher

Stanolind Company

Contractor

COMPLETED

NE NW


330 Ft. from N. Line

Ft. from S. Line

330 Ft. from E. Line

Ft. from W. Line

SECTION PLAT

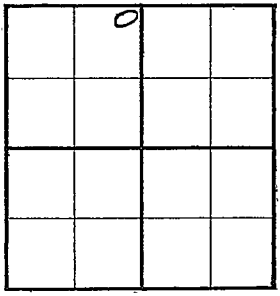

Location

Rig up

Drilling and Remarks:

2000 acid

P-178/4 + 189/4

Pot 1071

RECORD

Cased 6 in., 3669 ft.

~~Sand~~ Arb 3671

Gas

Oil

Total Depth 3684

PRODUCTION

1st 24 hrs. Nat.

1st 24 hrs. after shot

Gas Cu. Ft.

Dry Hole

Abandoned

Date

FEB 2 1938 19

H. D. Hatfield Scout