

Sec. 13 Twp. 22 R. 13W

Well No. #1 Metzlar Farm

Shawver-Graham Company

Drach Pool


800' Ft. from N. Line

_____ Ft. from S. Line

330' Ft. from E. Line

_____ Ft. from W. Line

SE NE NW

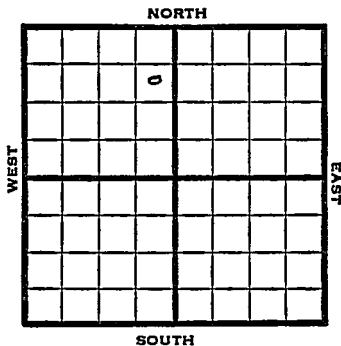

1949	# lev 1891' REPORT
4/27	8" @ 314' Drilg. 3020'
5/4	Lansing 3348' Viola 3594' Arbuckle 3672' TD 3676' 5" @ 3673' - 2000' oil
5/10	"
5/18	TD 3676' Arb. 3672' 5" @ 3673' Pump 30 Oil Pot 37° Gr. Comp
	COMPLETED

Map No. _____ Sec. 13 Twp. 22 R. 13W

Well No. 1 Metzlar

Shawver - Graham Company

FIRST REPORT

Contractor

SE NE NW

SECTION PLAT

800 Ft. from N. Line

_____ Ft. from S. Line

330 Ft. from E. Line

_____ Ft. from W. Line

Stafford County

Location _____

Rig up _____

Drilling and Remarks:

8" @ 314'

drlg 3020

RECORD

Cased _____ in., _____ ft.

Sand _____

Gas _____

Oil _____

Total Depth _____

PRODUCTION

1st 24 hrs. Nat. _____

1st 24 hrs. after shot _____

Gas _____ Cu. Ft.

Dry Hole _____

Abandoned _____

Date

APR 27 1949 19

S. J. LEWIS

Scout

Map No. KP2 Sec. 13 Twp. 22 R. 13W

Well No. 1 Metzlar

Shawver - Graham Company

COMPLETE

Contractor

SE NE NW

E. 1, 1891

SECTION PLAT

800 Ft. from N. Line

_____ Ft. from S. Line

330 Ft. from E. Line

_____ Ft. from W. Line

⁰Stafford County

Location _____

Rig up: _____

Drilling and Remarks:

Cor Y3672

5" Co 3673

Prod 30 oil Prod

37° SW

RECORD

Cased _____ in., _____ ft.

Sand _____

Gas _____

Oil _____

Total Depth 3676

PRODUCTION

1st 24 hrs. Nat. _____

1st 24 hrs. after shot: _____

Gas _____ Cu. Ft.

Dry Hole _____

Abandoned _____

Date

MAY 18 1949 19

S. J. LEWIS Scout