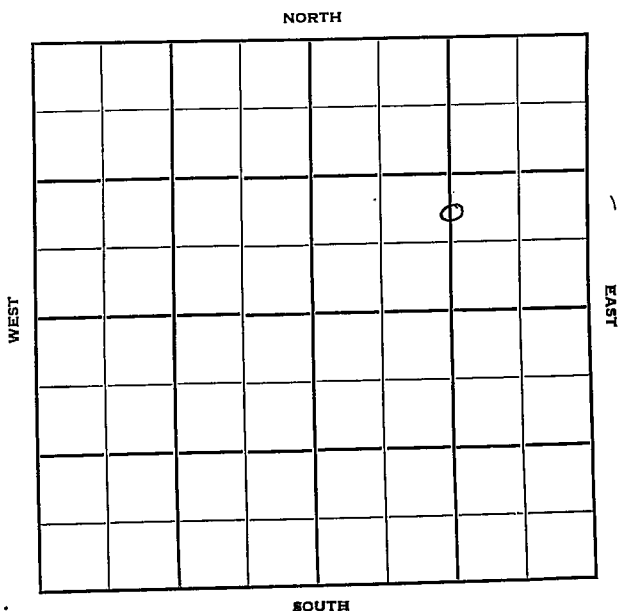


Section 13 Township 22 Range 13-WWell No. #1 SchartzCompany Wm Graham

13

22

13W

Sec. _____ Twp. _____ R. _____

Well No. #1 Schartz Farm _____

Wm. Graham Company _____

Contractor _____

_____ Ft. from N. Line

990'


_____ Ft. from S. Line

1320'

_____ Ft. from E. Line

_____ Ft. from W. Line

C N L S $\frac{1}{2}$ NE

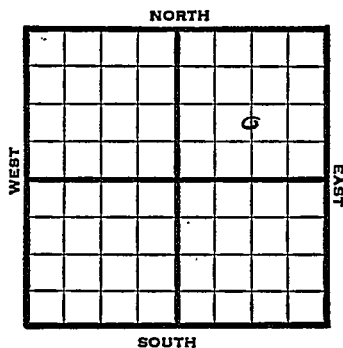

1950

Elev 1889'

REPORT

4/5

Spud 3-30-50

8-5/8" @ 250'

Dr1g. 2565'

TD 3677'

8 5/8" @ 250

Lans 3342'

Viola 3583'

Simp 3608'

Arb. 3675'

5" @ 3675'

Plug back to 3650

Perf 20/3642-47

14/3517-21

Est 25 BOPD

Comp

COMPLETED

5/3

Kansas


Map No. _____ Sec. 13 Twp. 22 R. 13WWell No. 1 Schartz

_____ Wm. Graham _____ Company

_____ Contractor

C N L S $\frac{1}{2}$ NE

SECTION PLAT

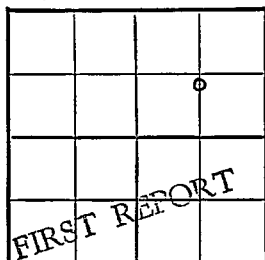

Stanolind farmout

Stafford County

Location _____

Rig up _____

Drilling and Remarks:

Spud 3-30-50

8 5/8" @ 250

drlg. 2565

RECORD

Cased _____ in., _____ ft.

Sand _____

Gas _____

Oil _____

Total Depth _____

PRODUCTION

1st 24 hrs. Nat. _____

1st 24 hrs. after shot _____

Gas _____ Cu. Ft.

Dry Hole _____

Abandoned _____


Date

APR 5 1950

19

J. E. TYRA _____ Scout

Kansas

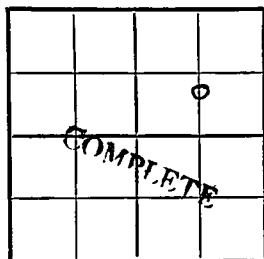Map No. _____ Sec. 13 Twp. 22 R. 13WWell No. 1 Schartz_____
Wm. Graham Company_____
C N L S $\frac{1}{2}$ NE ContractorEI. 1889
SECTION PLAT_____
Ft. from N. Line_____
990 Ft. from S. Line_____
1320 Ft. from E. Line_____
Ft. from W. Line_____
Stafford County_____
Location_____
Rig up_____
Drilling and Remarks:

8 $\frac{5}{8}$ " @ 250
Kans 3342
Viola 3583
Simp. 3608
Arb 3675
5" @ 3675

RECORD

Cased _____ in., _____ ft.

Sand _____

Gas _____

Oil _____

Total Depth 3677

PRODUCTION

1st 24 hrs. Nat. _____

1st 24 hrs. after shot _____

Gas _____ Cu. Ft.

Dry Hole _____

Abandoned _____

Date

(over)MAY 3 1950 19J. E. TYRA Scout

plug back to 3650

prof 20/3642-47

- 14/3577-21

est 25 BOPD

MAY 5 1950

Scout Cards
Land Small Map
Land Wall Map
Tracings
France Map
Pierce Map
Misc.