


Section 13 Township 22 Range 11W

Well No. #2 McMillan

Company Phillips

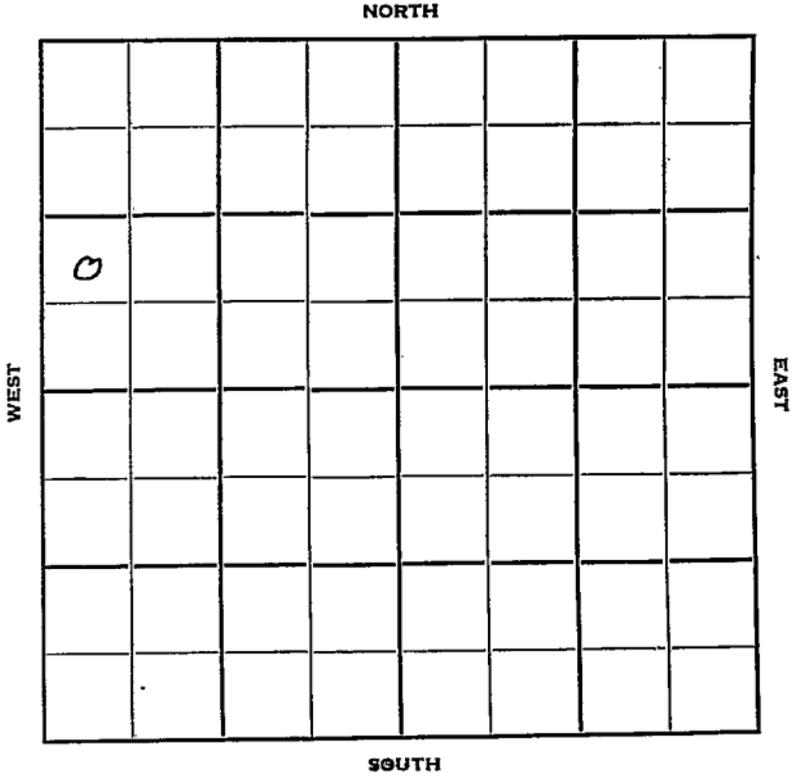

Stafford

KANSAS ✓

Sec. 13 Twp. 22 R. 14W

Well No. #2 McMillan Farm

Phillips Company

Sterling - Contr. Contractor


Ft. from N. Line

990' Ft. from S. Line

Ft. from E. Line

330' Ft. from W. Line

NW SW NW

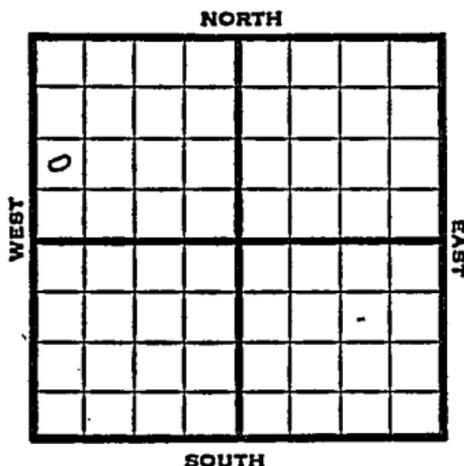

1952

Elev. 1932' REPORT

5/21
5/28
6/11

MI
 8" @ 375 Drlg. 2960'
 Spud 5-20-52
 D&A TD 3970' 8" @ 375'
 Heeb. 3295 Tor. 3317
 Br Li 3423 Lans. 3432
 B KC 3671 Viola 3719
 Simp. 3754 Arb. 3918
 TD 3970 D&A

ABANDONED

