


Section 13 Township 22 Range 11W

Well No. #1 McMillan (A)

Company Phillips Pet.

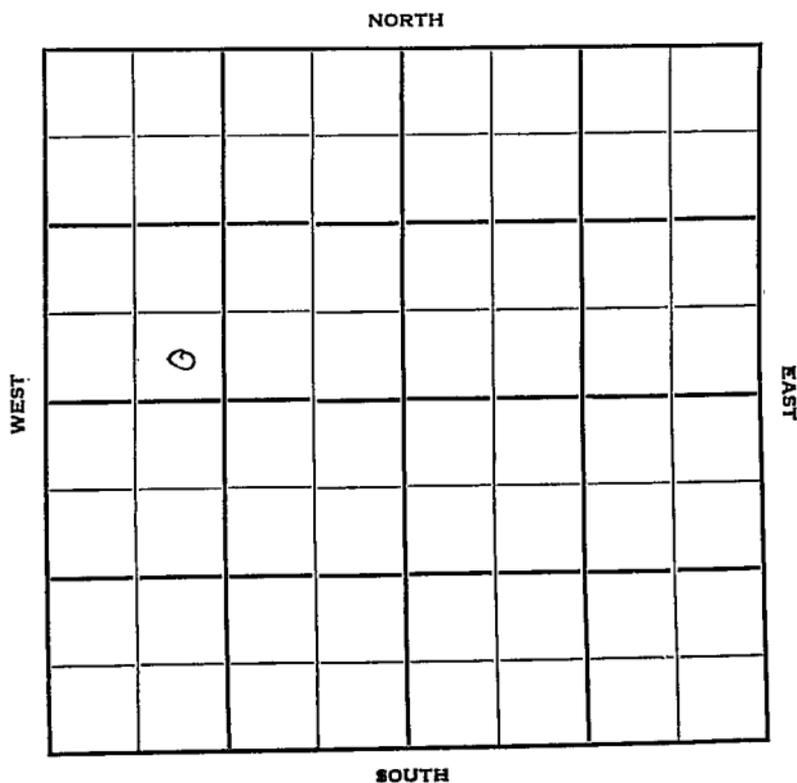

Sec. 13 Twp. 22 R. 14 W

Well No. # 1 McMillan (A) Farm

Phillips Pet. Company

Sterling Contractor


_____ Ft. from N. Line

330 Ft. from S. Line

_____ Ft. from E. Line

990 Ft. from W. Line

SE SW NW

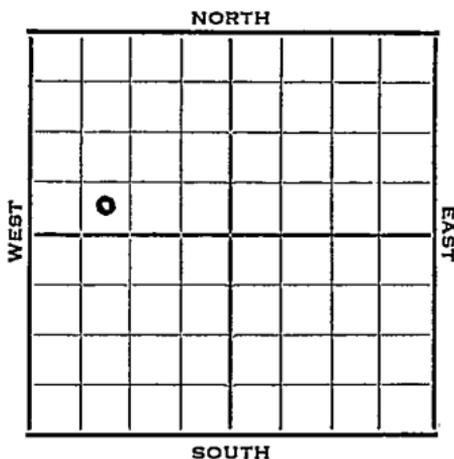

1952 Elev. 1930' REPORT

4/16 Spud 4-13-52
8" @ 375' WOC

4/23 Drlg. 3280'

4/30 Heeb 3282' Tor. 3303' Br li 3408'
Lans. 3421' B KC 3658' V. 3690'
Simp. 3721' Arb. 3773-77' TD
5" @ 3775'

5/7 DD 3785 TD S/33 BO 1st hr.
S/32½ BO 2 hrs. POP

5/14 NR

5/21 "

5/28 500 A P/140 BO 8 hrs.

6/4 Spud 4-13-52
Oil Well TD 3785'
8" @ 375' Heeb. 3282 Tor. 3303
Br. Li 3408 Lans. 3421
B KC 3658 Viola 3690
Simp. 3721 Arb. 3773-77
5" @ 3775' TD 3785 S/ 33 bo 1 hr.
S/ 32½ bo 2nd hr. P/ 140 bo 8 hr.
Comp. 2911 bopd 2% wtr.

COMPLETED

