


Section 13 Township 22 Range 11W

Well No. #1 Rita

Company Phillips

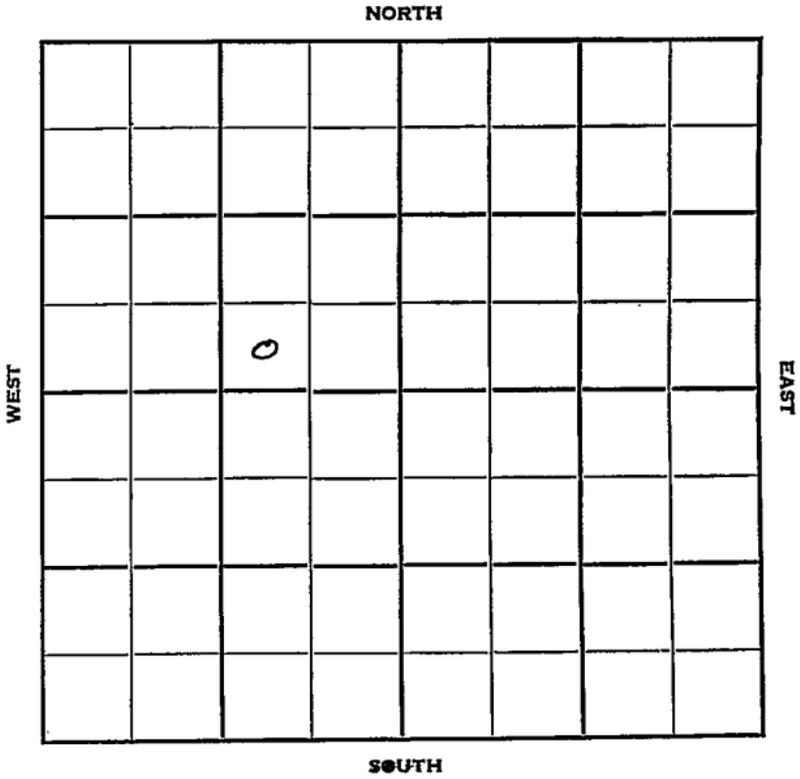

Sec. 13 Twp. 22 R. 14W

Well No. #1 Rita Farm

Phillips Company

Sterling - Contr. Contractor


Ft. from N. Line

330' Ft. from S. Line

990' Ft. from E. Line

Ft. from W. Line

SW SE NW

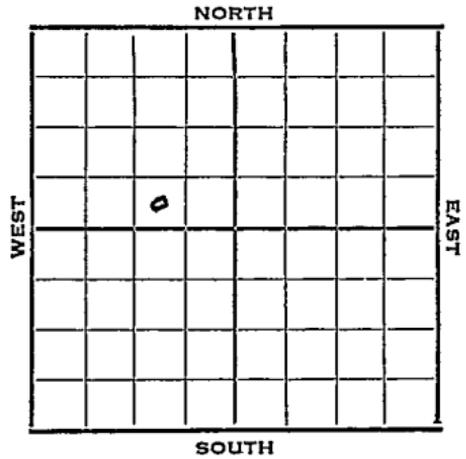

1952 Elev. 1927' REPORT

5/7 Location
 5/14 8" @ 376'
 Drlg. 3000'
 5/21 Heeb 3284 Tor. 3303 Br Li 3410
 B KC 3658 V 3688 Simp. 3725
 Arb. 3771 RTD 3775'
 5" @ 3772'
 5/28 DP DD 3782 S/4 $\frac{1}{2}$ BOPH for 4 hrs.
 500 A S/57 BO & 6% wtr 3 hrs.
 DD 3787 TD S/75 BO 2 hrs POP
 6/11 NR
 6/18 NR
 6/25 "
 7/2 Spud 5-6-52
 Oil well TD 3787' 8" @ 376'
 Heeb 3284' Tor. 3303' Br. lime 3410
 B KC 3658' Viola 3688' Simp. 3725'
 Arb. 3771' TD 3775' 5" @ 3772'
 DD 3782' S/4/64 BOPH 500 A
 S/57 BO 6% water. DD 3787'
 S/75 BO 2 hr.
 Comp. 1150 BOPD

COMPLETED


County Stafford State Kansas

Sec. 13 (Blk. 22 (Sur. 14W Map No. 14W)
(Twp.) (Rge.)

Operator Phillips Pet.

Well No. 1 Farm Rita

Elev. 1927 Location SW SE NW

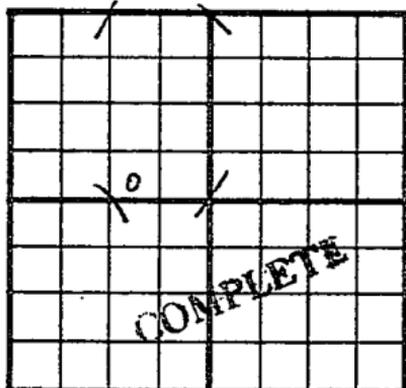

330 Ft. From S Line NW

990 Ft. From E Line Quarter

Ist. Report

Completion 1111 2 1952

Remarks

Sterling Drlg. - Contr.

Spudding Date 5-6-52

Drlg. Data Oil well TD 3787

8" @ 376 Heeb. 3284 Tor. 3303

Br. lime 3410 B KC 3658 Viola 3688

Simp. 3725 Arb. 3771 TD 3775

5" @ 3772 DD 3782 S/ 4/64 boph

500 A S/ 57 bo 6% water DD 3787

S/ 75 bo 2 hr. Comp. 1150 bopd