


Section 13 Township 22 Range 14 W

Well No. # 2 Rita

Company Phillips

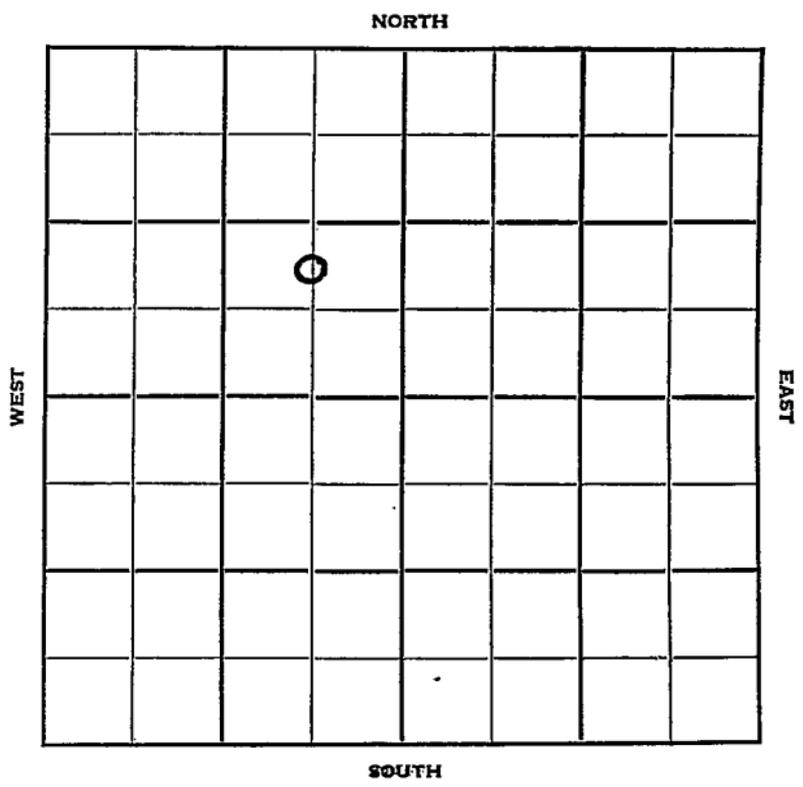

Sec. 13 Twp. 22 R. 11W ✓

Well No. #2 Ritaa Farm

Phillips Company

Contractor

Ft. from N. Line

990


Ft. from S. Line

Ft. from E. Line

660

Ft. from W. Line

C N L SE NW

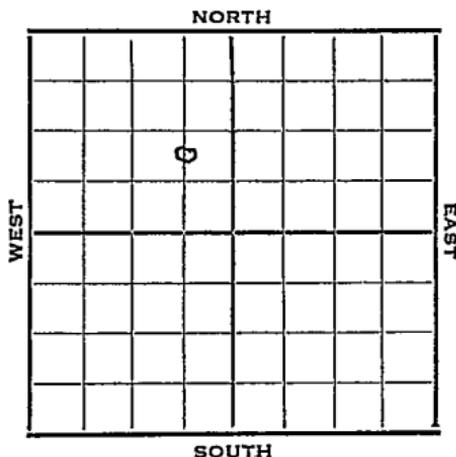

1952 Elev. 1926 REPORT

9/4 RUR
 9/10 8" @ 383'
 Drlg. 3378'
 9/17 Heeb. 3296 Tor. 3319
 Br Li 3416 Lans. 3426
 B KC 3658 V 3689
 Simp. 3729 Arb. 3775
 TD 3377' 5" @ 3775'
 9/24 CO DD 3779 Scum oil 50 A No help
 DD 3786 S/4 BO 5 hrs 500A
 S/18 BO 10 hrs. 1000 A S/12 BO
 11 hrs. DD 3790 S/29 BO 4 hrs.
 10/1 POP
 10/15 Spud Date: 9-352
 Drlg. Data: Oil well TD 3790'
 8" @ 383'
 Heeb 3296, Tor. 3319, Br. Lime 3416,
 Lans 3426, B KC 3658, Viola 3689,
 Simp 3729, Arb 3775
 TD 3777
 5" @ 3775
 DD 3779 scum oil 50A no help
 DD 3786 S/4 bo 5 hr., 500A
 S/ 18 bo 10 hr., 1000A S/12 BO
 11 hr., DD 3790 S/29 bo 4 hr.
 P/144 bopd
 Comp. 232 bopd 4% wtr.

COMPLETED

County Stafford State Kansas

Sec. 13 (Blk. Twp.) 22 (Sur. Rge.) 14W Map No.

Operator Phillips

Well No. 2 Farm Rita

Elev. _____ Location C N E. SE NW

990Ft. From S Line NW

660Ft. From Line Quarter

1st. Report SEP 4 1952

Completion _____

Remarks _____

Spudding Date _____

Drlg. Data _____

RUR

