

Section 13 Township 22 Range 14 WWell No. # 3 RitaCompany Phillips Petr.

		0					

NORTH


WEST

EAST

SOUTH

Stafford **KANSAS** ✓Sec. 13 Twp. 22 R. 14WWell No. #3 Rita FarmPhillips Petroleum Company Contractor330 Ft. from N. Line Ft. from S. Line977 Ft. from E. Line Ft. from W. Line

NW NE NW

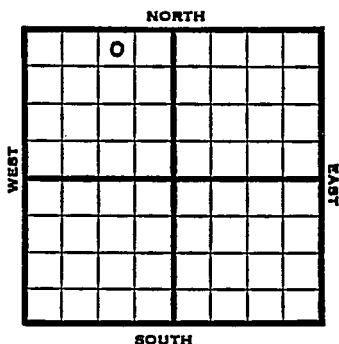

1952 Elev. 1929' REPORT

12/3 Location

12/11 RUR

12/18 8" @ 38 1/4 Heeb 3286 Tor 3307 Br 1 3408
Lans 3420 Ø3462

12/23 Spud 12-10-52
 D & A TD 3856' 8" @ 38 1/4 Heeb 3286'
 Tor. 3307' Br. line 3408' Lans 3420'
 DST 3560-70 open 1 hr. rec 240' 0 &
 GCM & wtr., 300' SW 990#
 DST 3574-90 open 1 hr. rec 68' mud
 1190# Viola 3690' Simp. 3726'
 Arb. 3781'
 DST 3792-92 open 1 hr. rec 30' mud 0#
 TD 3856
 DST 3695-3725 open 1 hr. rec 20' mud
 D & A

ABANDONED

3781
 1929
 1852

County **Stafford** State **Kansas**Sec. **13** (Blk. Twp.) **22** (Sur. Rge.) **14W** Map No.Operator **Phillips Petroleum**Well No. **3** Farm **Rita**Elev. Location **NW NE NW**

		0					

330 Ft. From **N** Line **NW****977** Ft. From **E** Line Quarter1st. Report **DEC 3 1952**

Completion

Remarks

Spudding Date

Drlg. Data

Location

J. G. McGEHEE

County Stafford State Kansas
 Sec. 13 (Blk. 22 (Sur. 14W Map No.
 (Twp.) (Rge.)
 Operator Phillips Petroleum
 Well No. 3 Farm Rita
 Elev. 1929 Location NW NE NW

		0					

330 Ft. From N Line NW

977 Ft. From E Line Quarter

1st. Report

Completion DEC 23 '52

Remarks

Spudding Date 12-10-52

Drig. Data D. & A - TD 3856

8" @ 384 Heeb. 3286 Tor. 3307

Br. lime 3408 Lans. 3420 DST 3560-70

open 1 hr. Rec. 240' o & gcm & wtr.

300' sw 990# DST 3574-90 open 1 hr.

Rec. 68' mud 1190# Viola. 3690

Simp. 3726 Arb. 3781 DST 3782-92

open 1 hr. Rec. 30' mud 0# TD 3856

DST 3695-3725 open 1 hr. Rec. 20' mud

D & A

J. G. McGEHEE