


Section 13 Township 22 Range 14 W

Well No. # 2 Thayer

Company Phillips Pet.

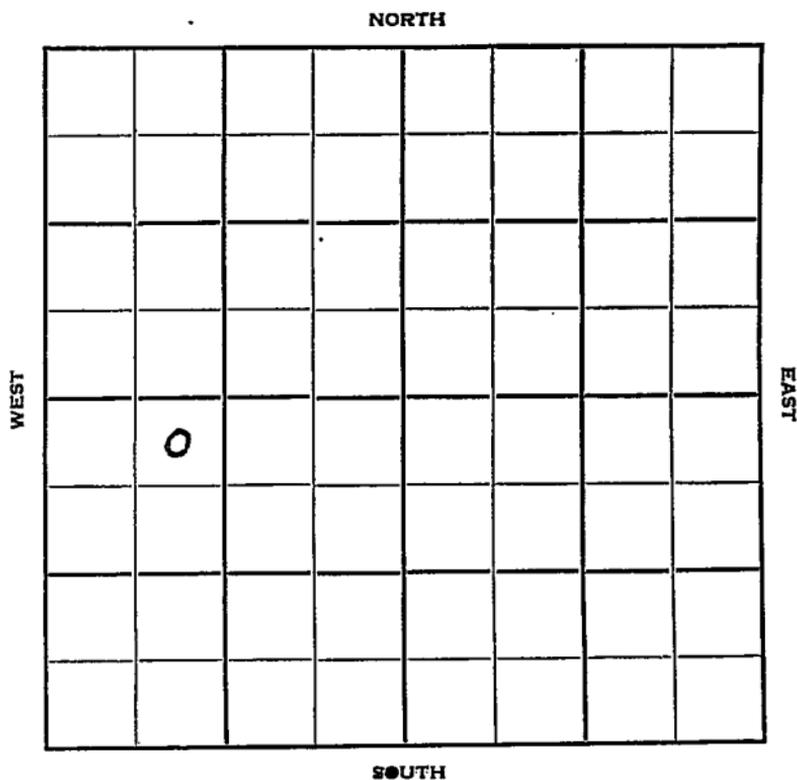

Sec. 13 Twp. 22 R. 14 W ✓

Well No. # 2 Thayer Farm

Phillips Pet. Company

Burwick Contractor
Oscor N


330 Ft. from N. Line

_____ Ft. from S. Line

_____ Ft. from E. Line

990 Ft. from W. Line

NE NW SW

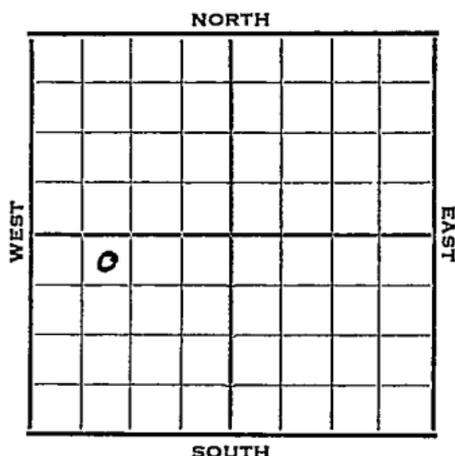

1952 Elev. 1927' REPORT

2/27 Spud 2-23-52
8" @ 322'
Anhy 830'
Drlg. 1950'

3/5 Heeb. 3284 Tor. 3303
Br Li 3409 L. s. 3421
V 3688 Simp Sh 3719
Simp Dol. 3751 Simp Sd 3769
Arb. 3770 TD 3773 Rung Schl.

3/12 5" @ 3771 CO to 3773
540' oil in hole DD to 3777 TD
S/87 BO 1½ hrs. POP

3/19 POP

4/2 Spud 2-23-52
Oil Well TD 3777'
8" @ 322 Anhy 830 Heeb. 3284
Tor. 3303 Br Li 3409 Lans. 3421
Viola 3688 Simp. sh. 3719
Simp. dol. 3751 Simp sd. 3769
Arb. 3770
TD 3773 5" @ 3771 CO to 3773
FU 540' oil DD 3776 S/ 92 bo
4½ hr. DD 3777 S/ 87 bo 1½ hr.
500 A P/ 102 bo 7% wtr.
Comp. 2327 bopd

COMPLETED

County **Stafford** State **Kansas**

Sec. **13** (Blk. Twp.) **22** (Sur. Rge.) **14W** Map No.

Operator **Phillips Pet.**

Well No. **2** Farm **Thayer**

Elev. Location **NE NW SW**

FIRST REPORT

330 Ft. From **N** Line **SW**

990 Ft. From **W** Line **Quarter**

1st. Report **FEB 27 1952**

Completion

Remarks

Burwick - Contr.

Spudding Date **2-23-52**

Drlg. Data **Oscor N**

8" @ 322 Anhy 830 Drlg. 1950

J. G. MCGEHEE

