

Section 13 Township 22 Range 14 W

Well No. # 1 Wright

Company Lebsack & Buick Drlg.

NORTH

							o

WEST

EAST

SOUTH

Sec. 13 Twp. 22 R. 14W

Well No. #1 Wright Farm

Lebsack & Buick Drlg. Company

Buick Contractor

Semi-Wildcat


Ft. from N. Line

330 Ft. from S. Line

330 Ft. from E. Line

Ft. from W. Line

SE SE NE

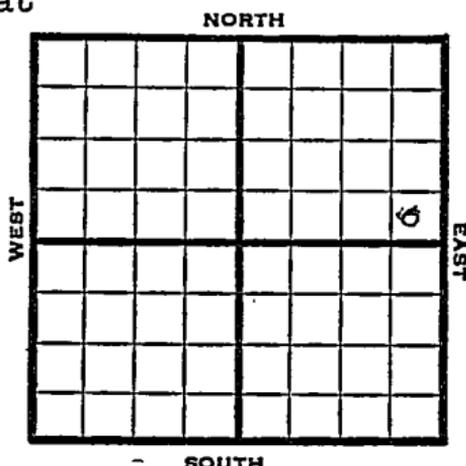

1952

Elev. 1922'

REPORT

4/2

Spud 3-27-52  
8" @ 343 Anhy 795'  
Drlg. 2017'

4/9

Heeb. 3308  
DST 3574-88  $\frac{1}{2}$  hr 8' M 220#  
Drlg. 3653'

4/16

Spud 3-27-52  
D&A TD 3888' 8" @ 343  
Anhy 795 Heeb. 3308  
Lans. 3455  
DST 3574-88 open  $\frac{1}{2}$  hr. rec. 8' mud  
B KC 3683 Cong. 3724  
Viola 3747 Simp. 3802  
Arb. 3863-88 TD  
D&A

**ABANDONED**

County **Stafford** State **Kansas**

Sec. **13** (Blk. Twp.) **22** (Sur. Rge.) **14W** Map No.

Operator **Lebsack & Buick Drlg.**

Well No. **\*1** Farm **Wright**

Elev. **1922** Location **SE SE NE**


**330** Ft. From **S** Line **NE**

**330** Ft. From **E** Line **Quarter**

1st. Report **APR 2 1952**

Completion

Remarks **CSO - F.O.**

**Buick - Contr.**

Spudding Date **3-28-52**

Drlg. Data **Semi Wildcat**

**8" @ 343 Anhy 795 Drlg. 2617**

**J. G. McGEHEE**


County Stafford State Kansas

Sec. 13 (Blk. Twp.) 22 (Sur. Rge.) 14W Map No.

Operator Lebsack & Buick Drlg.

Well No. 1 Farm Wright

Elev. 1922 Location SE SE NE

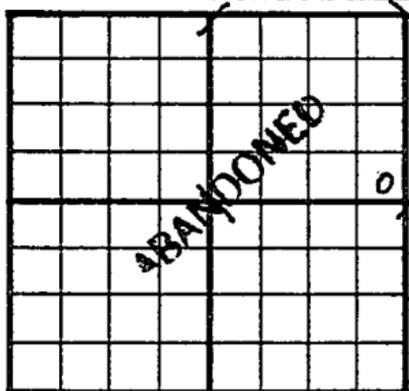

330 Ft. From S Line NE

330 Ft. From E Line Quarter

Ist. Report

Completion APR 16 1952

Remarks Semi Wildcat

Buick - Contr.

Spudding Date 3-27-52

Drlg. Data D & A TD 3888

8" @ 343 Anhy 795 Heeb. 3308

Lens. 3455 DST 3574-88 open 1/2 hr.

Rec. 8' mud B KC 3683 Cong. 3724

Viola 3747 Simp. 3802 Arb. 3863-88 TD

D & A