

DX 78-1


Stafford

KANSAS

Section 13 Township 22 Range 12 W

Well No. #1 Durham

Company Thunderbird Drlg.

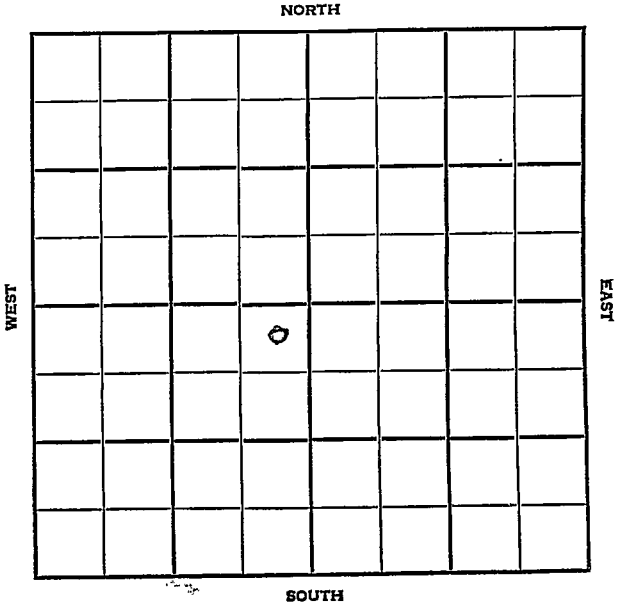

Stafford

KANSAS

SEC.	TWP.	R.
13	22	12W

WELL NO.

#1 Durham

FARM

COMPANY

ThunderBird Drlg.

CONTRACTOR

Co. Tools

Heyen


Ft. from N. Line

Ft. from S. Line

Ft. from E. Line

Ft. from W. Line

NE NE SW

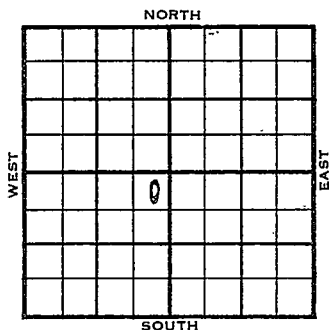

1956

ELEVATION

1840

REPORT

3-7

Comm. 2-29-56

8" @ 579/325

Drlg. 2660

4-4

DST 3642-45 op 1 hr. rec. 30' o&gcm,
370#

5½" @ 3642

CO to 3645, 500 A

S/ 4½ boph,

Pump 50 bopd,

Comp. 25 bopd

H. 3142

BL 3273

L. 3292

A. 3641

TD 3645

COMPLETED

County Stafford Elev. _____
 Sec. 13 Twp. 22 Rge. 12W
 Company Thunderbird Drlg.
 Farm Name Durham No. 1

TOPS	DEPTH	LOG	DATUM	Loc. in Sec.
Anh.				NE NE SW
Tr.				
H.				
Tr.				
Dg.				
Bl.				
L.				Geol.
K.C.				Contr.
B.K.C.				Co. tools
Ce.				Pool
C.				Heyen
M.				
M.				
K.				
Mz.				
Mo.				
V.				
S.				
S.				
A.				
R.				
Pf.				
G.				
T.D.				

FIRST REPORT
 MAR - 7 - 56

Date Comm. 2-29-56
8th @ 579/325 drlg. 2660

177

County	Stafford	Elev.	1840
Sec.	13	Twp.	22
Company	Thunderbolt Drlg.		
Farm Name	Durham	No.	1

TOPS	DEPTH	LOG	DATUM	Loc. in Sec.
Anh.				NE NE SW
Tr.				
H.	3142			
Tr.				
Dg.				
BL.	3273		1433	
L.	3292		1452	
K.C.				Geol.
B.K.C.				Contr.
Ce.				Co. tools
C.				
M.				
M.				Pool
K.				Heyen
Mz.				
Mq.				
V.				
S.				
S.				
A	3641		1801	COMPLETE
R.				0
PE.				
G.				APR 4 '55
TD.	3645			

Date Comm. 2-29-56

8" @ 579/325 DST 3642-45 open 1 hr.

rec. 30' o & gcm 370# 5 $\frac{1}{2}$ " @ 3642

CO to 3645 500 A S/ $4\frac{1}{2}$ boph

Pump. 50 bopd Comp. 25 bopd