


Stafford

KANSAS

Section 13 Township 22 Range 12W

Well No. #1 Teichmann

Company Petroleum Inc.

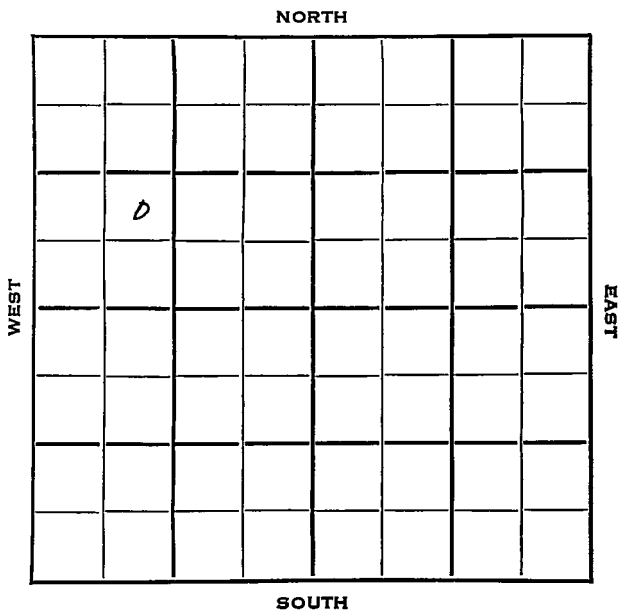

Stafford


Sec. 13 Twp. 22 R. 12WWell No. #1 Teichmann FarmPetroleum, Inc. CompanyGarvey Contractor1690 Ft. from N. Line

Ft. from S. Line

Ft. from E. Line

990 Ft. from W. Line

NE SW NW

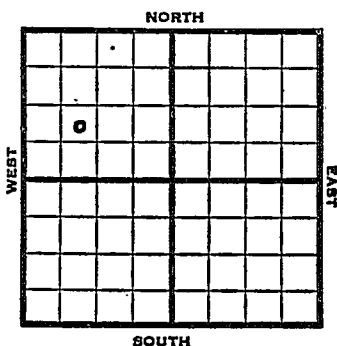

1953

Elev. 1847

REPORT

2/4

Spud 2-1-53

8" @ 198

Anhy 604

Dr1g. 1905'

2/12

Heeb 3141, KC 3291

DST 3314-70, 1/2 hrs., 60' M

225#

DST 3385-3440, 3/4 hrs., 10' M

Gong 3541

Dr1g. 3670

2/18

Spud 2-1-53 D & A TD 3700

8" @ 198 Anhy 604 Heeb 3141

KC 3291

DST 3314-70 open 1/2 hr. rec 60' mud

225#

DST 3384-3440 open 3/4 hr, rec 10' mud

Gong. 3541' TD 3700 D & A

ABANDONED


Sec. 13 (Blk. Twp.) 22 (Sur. Rge.) 12W Map No.

Operator Petroleum Inc.

Well No. 1 Farm Teichmann

Elev.		Location	NE SW NW
-------	--	----------	-----------------

0

FIRST REPORT

1690 Ft. From N Line NW

990 Ft. From IV Line Quarter

1st. Report FEB 4 1953

Completion

Remarks


Garvey - Contr.

Spudding Date **2-1-53**

Drlg. Data

8th @ 198 Anhy 604 drlg. 1905

J. G. McGEHEE

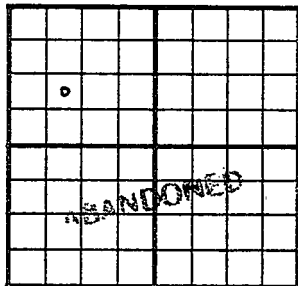County Stafford State KansasSec. 13 (Blk. Twp.) 22 (Sur. Rge.) 12W Map No.Operator Petroleum Inc.Well No. 1 Farm TeichmannElev. 1847 Location NE SW NW1690 Ft. From N Line NW990 Ft. From W Line Quarter1st. ReportCompletion FEB 18 1953RemarksGarvey - Contr.Spudding Date 2-1-53Drlg. Data D & A TD 37008" @ 198 Anhy 604 Heeb. 3141KC 3291 DST 3314-70 open $\frac{1}{2}$ hr.Rec. 60' mud 225# DST 3384-3440open $\frac{3}{4}$ hr. Rec. 10' mud Cong. 3541TD 3700D & A

J. G. McGEHEE