


Section 13 Township 22 Range 2-7<sup>th</sup>

Well Number 2-Hege

Company ~~Marathon~~ Ohio

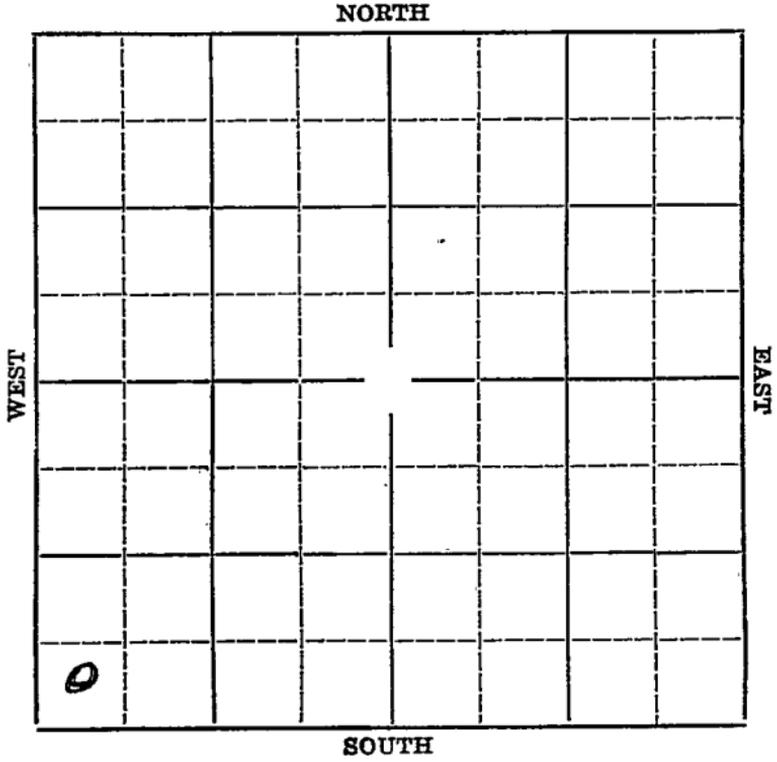

O. W. D. D

Map No. KANSAS Sec. 13 Twp. 22 R. 2W

Well No. #2 Hege Farm

Marathon Ohio Company


\_\_\_\_\_ Ft. from N. Line

330' Ft. from S. Line

\_\_\_\_\_ Ft. from E. Line

330' Ft. from W. Line

Elev. 1468

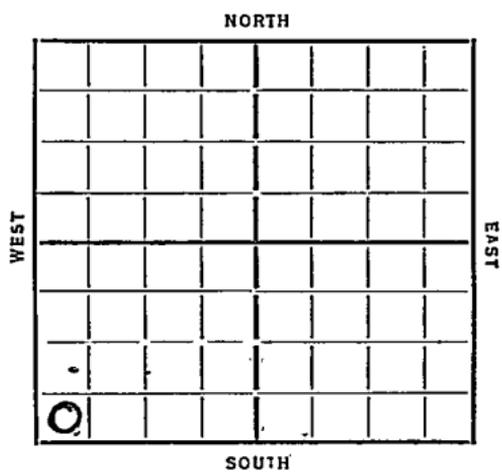

Date 1936 REPORT O. W. D. D

- 5/6 Location
- 5/14 Rigging up.
- 5/21 -- 5/28 -- 6/4 --
- 6/11 20" @ 125'. Waiting on cement.
- 6/18 Drlg. 450'.
- 6/25 Drlg. 1430'.
- 7/2 Drlg. 1950'.
- 7/9 Drlg. 2078'.
- 7/16 Drlg. 2118'.
- 7/23 2225'. Under ream 10".
- 7/30 10" @ 2300'. Drlg. 2440'.
- 8/6 Drlg. 2625'.
- 8/13 Kansas City 2305'. Chat 2915'.
- Set 8". Rig up standard tools.
- 8/20 Clean out.
- 8/26/36 - Chat 2915'.
- Gas 2919-60'.
- T.D. 2960'.
- 24 million cuft of gas.

COMPLETED

1938

O. W. D. D

- 8/3 Old T. D. 2960' in chat.  
Rig up to drill deeper.
- 8/12 7" - 2960'. Base Chat 30:55'.  
Dlg. 3060'.
- 8/19 Misner 3247-48'.  
Shut down.
- 8/26 Hunton 3249'. T. D. 3263'.  
7 bailers oil in 3 hrs.  
Rng. 5".
- 9/2 5" - 3248'. 1000' oil.  
1000 acid. Swab. 4 oil per hr.  
Deepened 3275' T. D.  
2000 acid.
- 9/7 Hunton 3249'.  
T. D. 3275'.  
1000 acid.  
2000 acid.  
Pump 164 bbls.

COMPLETED

Map No. Harvey 73 Sec. 13 Twp. 22 R. 2W

Well No. 2 Acge.

Marathon Company

Contractor

SECTION PLAT

0			

..... Ft. from N. Line

330 Ft. from S. Line

..... Ft. from E. Line

330 Ft. from W. Line

FIRST REPORT

Location ✓

Rig up .....

Drilling and Remarks:

RECORD

Cased..... in., ..... ft.

Sand.....

Gas.....

Oil.....

Total Depth.....

PRODUCTION

1st 24 hrs. Nat.....

1st 24 hrs. after shot.....

Gas..... Cu. Ft.

Dry Hole.....

Abandoned.....

Date

..... 192.....

..... Scout

**KANSAS**

Map No. 43 Sec. 13 Twp. 22 R. 2W.

Well No. 2 Nege

Marathon Company

Contractor

**SECTION PLAT**


\_\_\_\_\_ Ft. from N. Line

330 Ft. from S. Line

\_\_\_\_\_ Ft. from E. Line

330 Ft. from W. Line

**COMPLETED**

Location \_\_\_\_\_

Rig up \_\_\_\_\_

Drilling and Remarks:

Chat 2915  
Gas 2919-60

24 M Gas.

**RECORD**

Cased \_\_\_\_\_ in., \_\_\_\_\_ ft.

Sand \_\_\_\_\_

Gas \_\_\_\_\_

Oil \_\_\_\_\_

Total Depth 2960

**PRODUCTION**

1st 24 hrs. Nat. \_\_\_\_\_

1st 24 hrs. after shot \_\_\_\_\_

Gas \_\_\_\_\_ Cu. Ft.

Dry Hole \_\_\_\_\_

Abandoned \_\_\_\_\_

Date

AUG 26 1936 19

S. J. LEWIS Scout



Harvey

Map No. 43 Sec. 13 Twp. 22 R. 2W

Well No. 2 Hege

Ohio

Company

Contractor

COMPLETE

SW/C

SECTION PLAT


\_\_\_\_\_ Ft. from N. Line

330 Ft. from S. Line

\_\_\_\_\_ Ft. from E. Line

330 Ft. from W. Line

*ORVAL*

Location \_\_\_\_\_

Rig up \_\_\_\_\_

Drilling and Remarks:

*1000 acid  
2000 acid*

*164 bbls  
pumps*

RECORD

Cased \_\_\_\_\_ in., \_\_\_\_\_ ft.

Sand *Huntton 3249*

Gas \_\_\_\_\_

Oil \_\_\_\_\_

Total Depth 3275

PRODUCTION

1st 24 hrs. Nat. \_\_\_\_\_

1st 24 hrs. after shot \_\_\_\_\_

Gas \_\_\_\_\_ Cu. Ft.

Dry Hole \_\_\_\_\_

Abandoned \_\_\_\_\_

Date

SEP 7 - 1938 19 ORVAL MANNSCHRECK Scout