


Map No. KANSAS Sec. 13 Twp. 22 R. 2 W

Well No. 1-1000 Farm _____
Shurpik Oil Company _____

NORTH

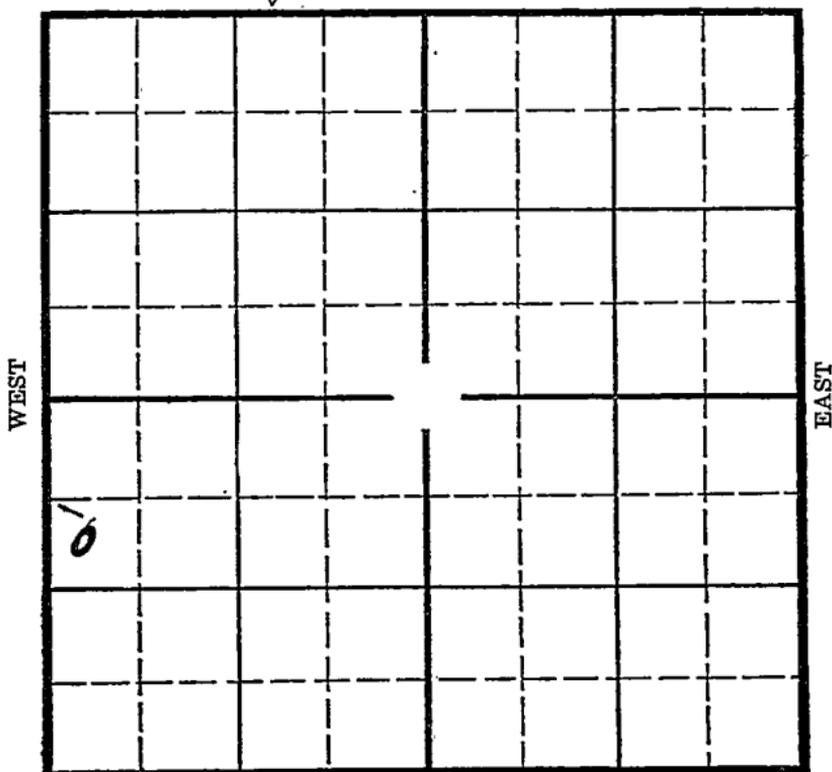

SOUTH

O. W. D. D

Location _____

Drilling Remarks _____

Rig Up _____

Drilling Remarks _____

RECORD

Cased _____ in. _____ ft.

Sand _____

Gas _____

Oil _____

Total Depth _____

PRODUCTION

1st 24 hrs. Nat. _____

1st 24 hrs. after shot _____

Gas _____ cu. ft. _____

Dry Hole _____


Abandoned _____

Harvey
22 2w

Map No. KANSAS Sec. 13 Twp. 22 R. 2w

Well No. 1- Heggy Farm _____
Sunny Oil Company _____

990 Ft. from N. Line
____ Ft. from S. Line
____ Ft. from E. Line
330 Ft. from W. Line

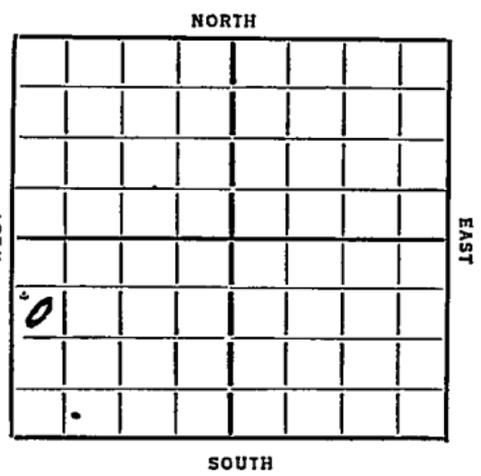

Elev. 1470

REPORT **O. W. D. D**

1935
11/27 Ponds & Material
12/6 M J Rotary
12/13 R N " "
12/19 Dlg 545 12" 145
12/26
1/2/36 Top Chat 2920 TD 2925
Ring 7"
1/10 7" 2925 Trying to kill gas
1/16 Chat 2920
TD 2960
9 M Gas.

COMPLETED

O. W. D. D

1938
7/27 Old T.D. 2960'.
Misner 3241'.
Hanton 3247'.
T.D. 3254'. No shows.
5" - 3240'. WOC.
8/5 " " " "

OVER

1938

8/12 T:D. 3262'. 300' oil. Fishg.

8/19 Dlg. 3270'.

8/26 T. D. 3283'. 1500' oil 6 hrs.

P. B. 3280'.

9/2 2500 acid.

9/7 T. D. 3283'.

P. B. to 3280'.

2500 acid.

Pump 542 bbls.

COMPLETED

Map No. 43 Sec. 13 Twp. 22 R. 2W

Well No. 1-Hegge

Sunray Oil Company

Contractor

FIRST REPORTS

990 Ft. from N. Line

..... Ft. from S. Line

..... Ft. from E. Line

330 Ft. from W. Line

SECTION PLAT

Location.....

Rig up.....

Drilling and Remarks:

Rounds & Material

RECORD

Cased.....in.,ft.

Sand.....

Gas.....

Oil.....

Total Depth.....

PRODUCTION

1st 24 hrs. Nat.....

1st 24 hrs. after shot.....

Gas.....Cu. Ft.

Dry Hole.....

Abandoned.....

Date

11-27-35 192.....

ORVAL MANNSCHRECK

Scout

Map No. 43 Sec. 13 Twp. 22 R. 2WWell No. 1-HeggeSunray Oil Company

Contractor

COMPLETE

SECTION PLAT

990 Ft. from N. Line

Ft. from S. Line

Ft. from E. Line

330 Ft. from W. Line

0			

Location.....

Rig up.....

Drilling and Remarks:

9 m gas

RECORD

Cased..... in., ft.

Sand chat 2920

Gas.....

Oil.....

Total Depth 2960

PRODUCTION

1st 24 hrs. Nat.....

1st 24 hrs. after shot.....

Gas..... Cu. Ft.

Dry Hole.....

Abandoned.....

Date

1-16-36 192.....

ORVAL MANNING

TICK

Scout

Map No. 43 Sec. 13 Twp. 22 R. 2W

Well No. 1 Hegge

Sunray Oil Company

Contractor

FIRST REPORT

SECTION PLAT

990 SW NW SW
Ft. from N. Line
____ Ft. from S. Line
____ Ft. from E. Line
330 Ft. from W. Line

Location _____

Rig up _____

Drilling and Remarks:

OWDD-OTD 2960

Misener 3241

Hunton 3247

TD 3254

No Shows

5" 3240

WOC

RECORD

Cased _____ in., _____ ft.

Sand _____

Gas _____

Oil _____

Total Depth _____

PRODUCTION

1st 24 hrs. Nat. _____

1st 24 hrs. after shot _____

Gas _____ Cu. Ft.

Dry Hole _____

Abandoned _____

Date

JUL 27 1933 19

H. D. Hatfield

Scout

Map No. 43 Sec. 13 Twp. 22 R. 2W

Well No. 1 Hegge

Sunray Oil Company

Contractor

COMPLETED

SECTION PLAT

SW NW SW

990 Ft. from N. Line

_____ Ft. from S. Line

_____ Ft. from E. Line

330 Ft. from W. Line

EW 210

Location _____

Rig up _____

Drilling and Remarks:

P.B. 3280

2500 acid

542 lbs

pump

RECORD

Cased _____ in., _____ ft.

Sand _____

Gas _____

Oil _____

Total Depth 3283

PRODUCTION

1st 24 hrs. Nat. _____

1st 24 hrs. after shot _____

Gas _____ Cu. Ft.

Dry Hole _____

Abandoned _____

Date

SEP 7 - 1938₁₉

ORVAL MANNSCHRECK
Scout