


Finney

KANSAS

SECTION 13 TOWNSHIP 22 S RANGE 32 WWELL NO. # 1 BoydCOMPANY A. McKelvy

NORTH Appx. C NE/4

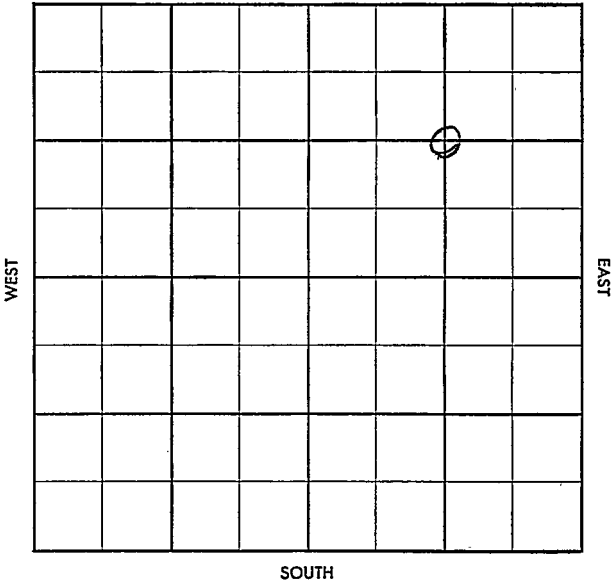

~~Top~~ ~~Post~~
~~Co~~ ~~Foot~~


County Finney Elev. _____
 Sec. 13 Twp. 22 Rge. 32W
 Company A. McKelvy
 Farm Name Boyd No. 1

TOPS	DEPTH	LOG	DATUM
Anh.			
Tp.			
H.			
Tr.			
Dg.			
B.L.			
L.			
K.C.			
B.K.C.			
Ce.			
C.			
M.			
M.			
K.			
Mz.			
Mq.			
V.			
S.			
S.			
A.			
R.			
Pf.			
G.			
T.D.			

Loc. in Sec. _____
App C NE/4
1250' N & E
of C Sec.

Geol. _____
 Contr. _____
G-M #6

Pool _____
Hugoton

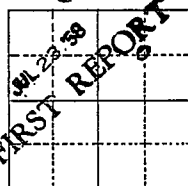

Date Comm. 7-18-58
no surface, Drlg. 2705.

Co.

Lse.

No.

Sec.

T.

R.

~~Twp.~~ ~~Pool~~
~~Co.~~ ~~Facet~~

S-513-B


County Finner Elev. 2932 DF
 Sec. 13 Twp. 22 Rge. 32 W
 Company A. C. Kelly
 Farm Name Boyd No. 1

TOPS	DEPTH	LOG	DATUM
Anh. <u>Herr</u>		<u>2690</u>	
Tp. <u>U. K. Rd</u>		<u>2716</u>	
H. <u>K. Rd</u>		<u>2737</u>	
Tr. <u>W. Rd</u>		<u>2774</u>	
Dg.			
B. L.			
L.			
K. C.			
B. K. C.			
C.			
C.			
M.			
M.			
K.			
Mz.			
Mq.			
V.			
S.			
S.			
A.			
R.			
Pf.			
G.			
T.D.	<u>2810</u>		

Loc. in Sec. _____
 App C ME/4
 1250' N & E
 of C Sec.

Geol. _____
 Contr. _____
 G-A #6

Pool _____
 Ungoton

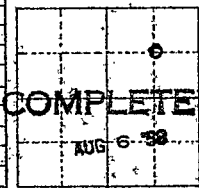

Date Comm. 7-18-58
 no surface, Drilling 2705. JUL 30 58 log
5' 2799' / AUG 6 58 CO 2749' 40'
2720-30' / 2 gr 6 38 MCF Frac
6 x 3 10 hr B10 down 3,710 MCF
72-20 11,000 MCF RP 428