

Section 13 Township 22 Range 33 WWell No. # 1 Lee KisnerCompany Texas Company

						0	

NORTH

WEST

EAST

SOUTH

Finney KANSAS


SEC.	13	TWP.	22	R.	33W ✓
WELL NO.					
1 Lee Kisner					FARM
COMPANY					
Texas Company					
CONTRACTOR Wildcat					

990 _____ Ft. from N. Line

_____ Ft. from S. Line

990 _____ Ft. from E. Line

_____ Ft. from W. Line

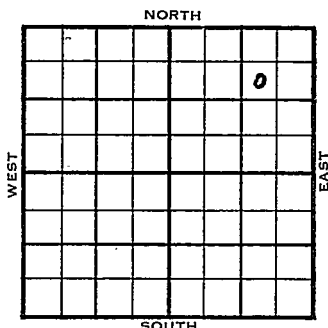

SW NE NE

	ELEVATION	REPORT
1953	2887'	
11/18	Location	
12/9	10" @ 498'	
	Hol 2579', Her 2605', Kr 2625', Win 2649', Top 3536', Heeb 3831', Lans 3871'	
	Drlg. 4019'	
12/16	DST 4107'-24' 1 hr, 2360' sulp wtr 1125# Marm 4369'	
	DST 4515'-46' 1 hr, 25' M	
	Drlg 4546'	
1954		
1/27	Spud 11-23-53	
	Gas Well	
	TD 4952'	
	10-3/4" @ 498'	
	Hol. 2579', Her 2605', Kri 2625'	
	Win 2649', Top 3536', Heeb 3888', Lans 3938',	
	DST 4107'-24' opn 1 hr, rec 2360' sul wtr. 1125#	
	Marm 4442'	
	DST 4515'-46' opn 1 hr, rec 25' dlrg mud, Miss 4787',	
	DST 4657'-68' opn 1½ hr, rec 4' Mud, 0#	

OVER

1954

Information brought forward.

1/27 EST 4813'-4911' opn 1 hr, rec 35' Mud
104#
St. Louis 4909'
TD 4952'
7" @ 2750'
CO to 2709'
32/ 2662-70 $\frac{1}{2}$ mcfg 10 gwph 500 A
1,640,000 gas 8 gwph 2000 A
120/ 2608-38 5000 A 2-3/4 mcfg
70 gwph
32/ 2580-88 1000 A $3\frac{1}{2}$ mcfg 7 gwph
Comp 8,406,000 gas

COMPLETED

County Finney State Kansas

Sec. 13 (Blk. 22 (Sur. 33W Map No. _____)

Operator Texas Company

Well No. 7 Farm Lee Kisner

Elev.	Location	SW	NE	SE
-------	----------	----	----	----

0

FIRST REPORT

990 Ft. From N Line NW

990 Ft. From 7 Line Quarter

1st. Report NOV 18 1953

Completion

Remarks


Spudding Date

Drig. Data Wildcat

Location

J. G. McGEHEE

County Finney State Kansas
 Sec. 13 (Blk.) 22 (Sur.) 33W Map No. 1
 Operator Texas Company
 Well No. 1 Farm Lee Kisner
 Elev. 2887 Location SW NE NE

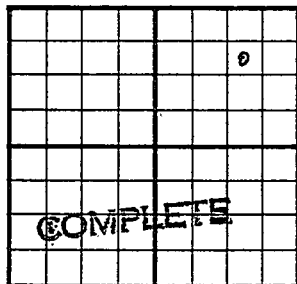

990 Ft. From N Line NE
990 Ft. From E Line Quarter.

1st. Report

Completion JAN 27 1954

Remarks Wildcat

Spudding Date 11-23-53

Drlg. Data Gas well TD 4952

10 3/4" @ 498 Hol. 2579. Her. 2605

Kri. 2625 Win. 2649 Top. 3536

Heeb. 3888 Lans. 3938 DST 4107-24

open 1 hr. Rec. 2360' sul. wtr. 1125#

Marm. 4442 DST 4515-46 open 1 hr.

Rec. 25' drlg. mud Miss. 4787

DST 4657-68 open 1 1/2 hr. Rec. 4' mud

0# DST 4813-4911 open 1 hr. Rec.

35' mud 104# St. Louis 4909

TD 4952 7" @ 2750 CO to 2709

32/ 2662-70 1/2 mcf/g 10 gwph 500 A

1,640,000 gas 8 gwph 2000 A

120/ 2608-38 5000 A 2 3/4 mcf/g 70 gwph

32/ 2580-88 1000 A 3 1/2 mcf/g 7 gwph

Comp. 8,406,000 gas

J. G. McGEHEE