

Finney


KANSAS

DX 78-1

Section 13 Township 22 Range 34W

Well No. #1 Garden City

Company Jay Kornfeld

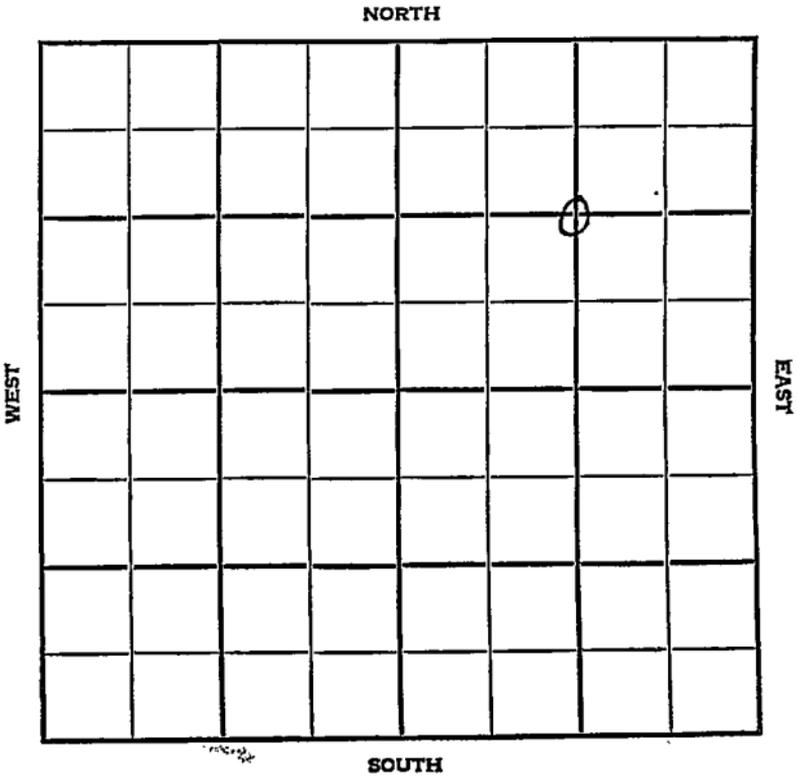

[Small handwritten mark]

Finney

SEC.	TWP.	R.
13	22	34W

WELL NO. #1 Garden City FARM
 COMPANY

CONTRACTOR Jay Kornfeld.

Michaelis Drlg.


Hugoton Pool NORTH

1320 Ft. from N. Line

Ft. from S. Line

1320 Ft. from E. Line

Ft. from W. Line

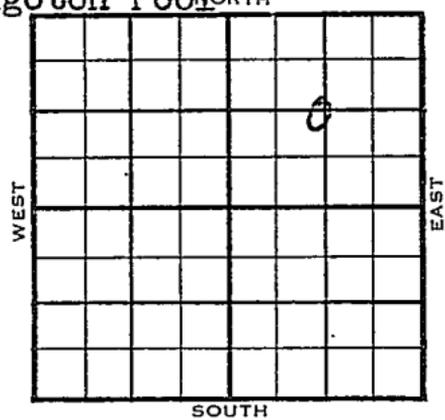

C NE/4

	ELEVATION	REPORT
1955	2916'	

4/6

Spud 4-2-55
 8" @ 298'

4/20

Drlg. 1960'
 pud 4-2-55 - Gas Well
 TD 2559'
 8" @ 298'
 Her. 2535'
 TD 2542'
 DD 2559'
 5" @ 2535', 1,100,000 cfg frac
 Comp. 2,600,000 cfigpd

COMPLETED

