

GLOBE OILWELL CEMENTING, Inc.

TEMPERATURE SURVEY


Date 2-28-65 Place Hudson, Kansas
Company Name Graves Drilling Co. Inc. Order No. _____
Mail Address _____ City Wichita State Kansas
Owner of Well Same Contractor Company Tools

Well No. 1 Farm Staub County Stafford Sec. _____ Tp. _____ Rge. _____

Depth of Well 3839 Depth of Csg. Cmd. 3684 Casing { New } Size 5 1/2 Size of Hole 7 7/8
{ Used } Weight 14 Amount of Cement 125
Kind of Cement Port.

Top Cement 3375 Run No. _____ { Rotary } w/ FRA
{ Cable }

Survey From Ground Level Ft. To 3643 Ft. {

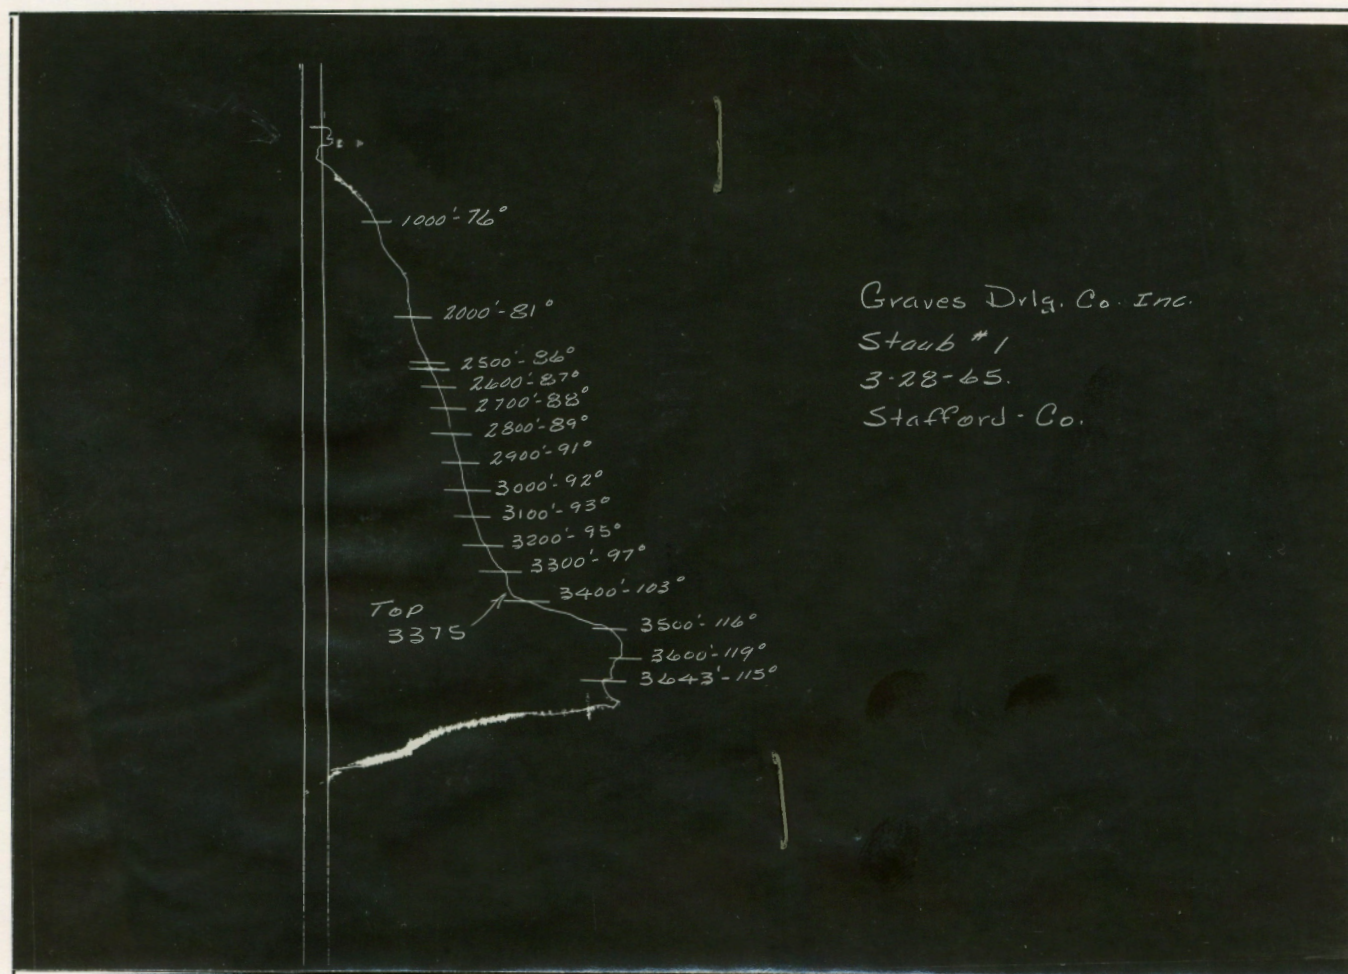

This is an actual photograph of recorder chart.