


KANSAS

Stafford

Section 14 Township 22 Range 13WWell No. 1 HowardCompany Great Lakes Carbon et al

Kenilworth

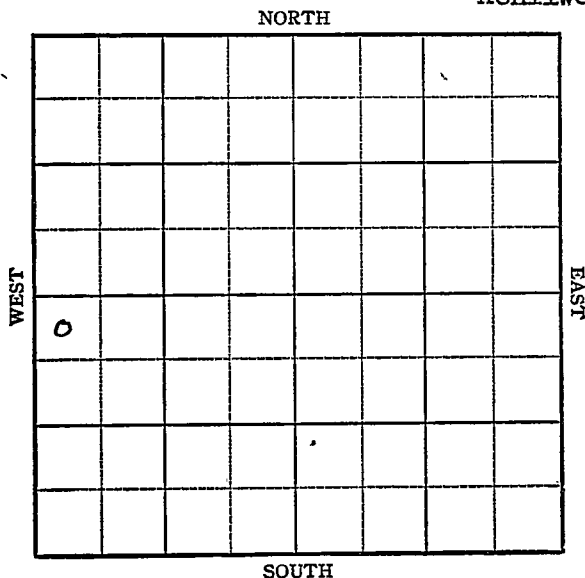

KANSAS

Stafford

Sec. 14 Twp. 22 R. 13W ✓Well No. #1 Howard Farm

Great Lakes Carbon et al

Company

Kenilworth Pool


330' Ft. from N. Line

Ft. from S. Line

Ft. from E. Line

330' Ft. from W. Line

NW SW

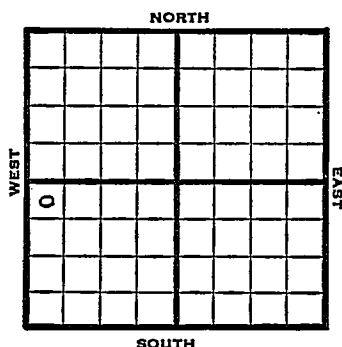

1949

Elv 1889'

REPORT


1/12	Location
1/19	8" @ 282'
	Drlg 1716'
1/26	Drlg 3235'
2/2	Lans 3363?
	TD 3792'
	Ar b 3781-92
	5" @ 3781'
2/9	Swb 10 bbls oil PH, 4 hrs.
2/16	"
2/23	"
3/2	"
3/8	"
3/16	"
3/23	1500 acid
	Pump 104 bbls oil 6 hrs.
3/30	"
4/6	"
4/12	"
4/20	"
4/27	"
5/4	TD 3792'
	Arb. 3781'
	5 @ 3781
	1500 acid
	Pump 597 Oil / 15% W Pot
	39° Gr.
	Comp

COMPLETED

KalamazooMap No. _____ Sec. 14 Twp. 22 R. 13WWell No. 1 HowardGreat Lakes Carbon etal. CompanyFIRST REPORT Contractor

NW SW

SECTION PLAT

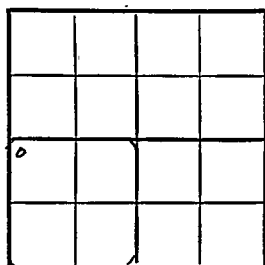330 Ft. from N. Line

_____ Ft. from S. Line

_____ Ft. from E. Line

330 Ft. from W. LineStafford County

RECORD

Location X

Cased _____ in., _____ ft.

Rig up _____

Sand _____

Drilling and Remarks: _____

Gas _____

Oil _____

Total Depth _____

PRODUCTION

1st 24 hrs. Nat. _____

1st 24 hrs. after shot _____

Gas _____ Cu. Ft.

Dry Hole _____

Abandoned _____

Date

JAN 12 1949 19S. J. LEWIS Scout

Map No. K82 ^{Kansas} Sec. 14 Twp. 22 R. 13W

Well No. 1 Howard

Great Lakes Carbon etal. Company

COMPLETE

Contractor

NW SW

E 11888
SECTION PLAT

0			

330 Ft. from N. Line

_____ Ft. from S. Line

_____ Ft. from E. Line

330 Ft. from W. Line

Stafford County

Location _____

Rig up _____

Drilling and Remarks:

Cr 89781

5" 89787

1500 acid

Prod 597 oil + 15% gas

Pat

892 in

RECORD

Cased _____ in., _____ ft.

Sand _____

Gas _____

Oil _____

Total Depth 3792

PRODUCTION

1st 24 hrs. Nat. _____

1st 24 hrs. after shot _____

Gas _____ Cu. Ft.

Dry Hole _____

Abandoned _____

Date

MAY 4 1949

S. I LEWIS Scout