

KANSAS

Stafford

Section 14 Township 22 Range 13W

Well No. 2 Howard

Company Great Lakes Carbon

Drach

NORTH

WEST								EAST

SOUTH

KANSAS

Stafford

Sec. 14 Twp. 22 R. 13W ✓

Well No. #2 Howard Farm

Great Lakes Carbon Company

Drach Pool


990' Ft. from N. Line

 Ft. from S. Line

 Ft. from E. Line

990' Ft. from W. Line

SE NW SW

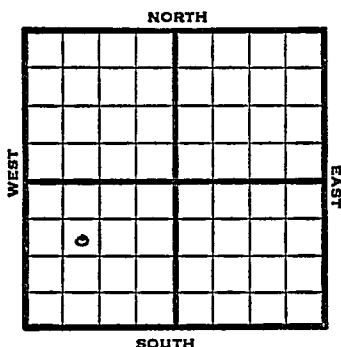

1949

Elev 1891'

R E P O R T

5/18

Location

5/25

"

6/1

8" @ 268'

Drlg 1165'

6/7

Drlg 3350'

6/15

Viola 3755'

TD 3820 in Viola

Aband.

ABANDONED

Kansas

Drach Pool

Map No. _____ Sec. 14 Twp. 22 R. 13WWell No. 2 Howard

Great Lakes Carbon Company

Contractor

SE NW SW

FIRST REPORT
SECTION PLAT990 Ft. from N. Line

_____ Ft. from S. Line

_____ Ft. from E. Line

990 Ft. from W. Line

Stafford County

Location X

Rig up _____

Drilling and Remarks:

RECORD

Cased _____ in., _____ ft.

Sand _____

Gas _____

Oil _____

Total Depth _____

PRODUCTION

1st 24 hrs. Nat. _____

1st 24 hrs. after shot _____

Gas _____ Cu. Ft.

Dry Hole _____

Abandoned _____

Date

MAY 18 1949 19

S. J. LEWIS

Scout

